FROM THE OFFICE OF

Certificate of Survey

CHARLES O. GEORGI COMPANY

2215 West County Road B

Saint Paul, Minnesota 55113


REGISTERED CIVIL ENGINEER AND LAND SURVEYOR

I Hereby Certify that this plat shows a survey made by me of the property described on this plat, and that the corners are correctly placed as shown, and that all locations have been correctly shown.

Surveyed For Mary Zerwas Date April, 1972

Description:

Lot 10, McClung's Subdivision of Block 69 of Brown and Jackson Addition to W. St. Paul. Ramsey County, Minnesota

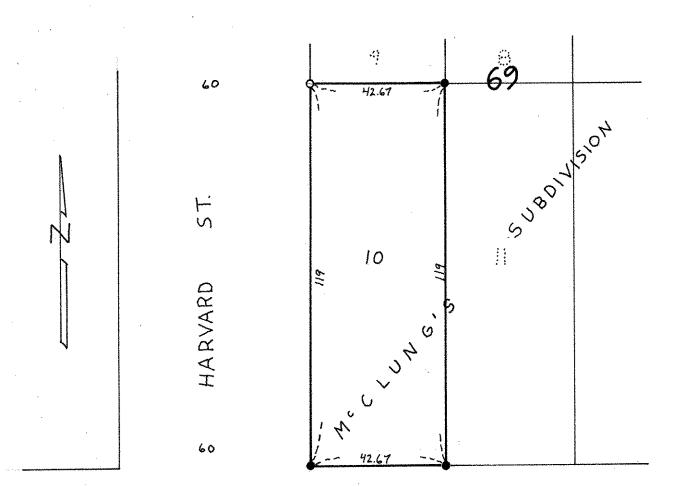

ANNAPOLIS ST.

9

O Denotes Iron Pipe Monument

Denotes Iron Pipe Monument Found In Place