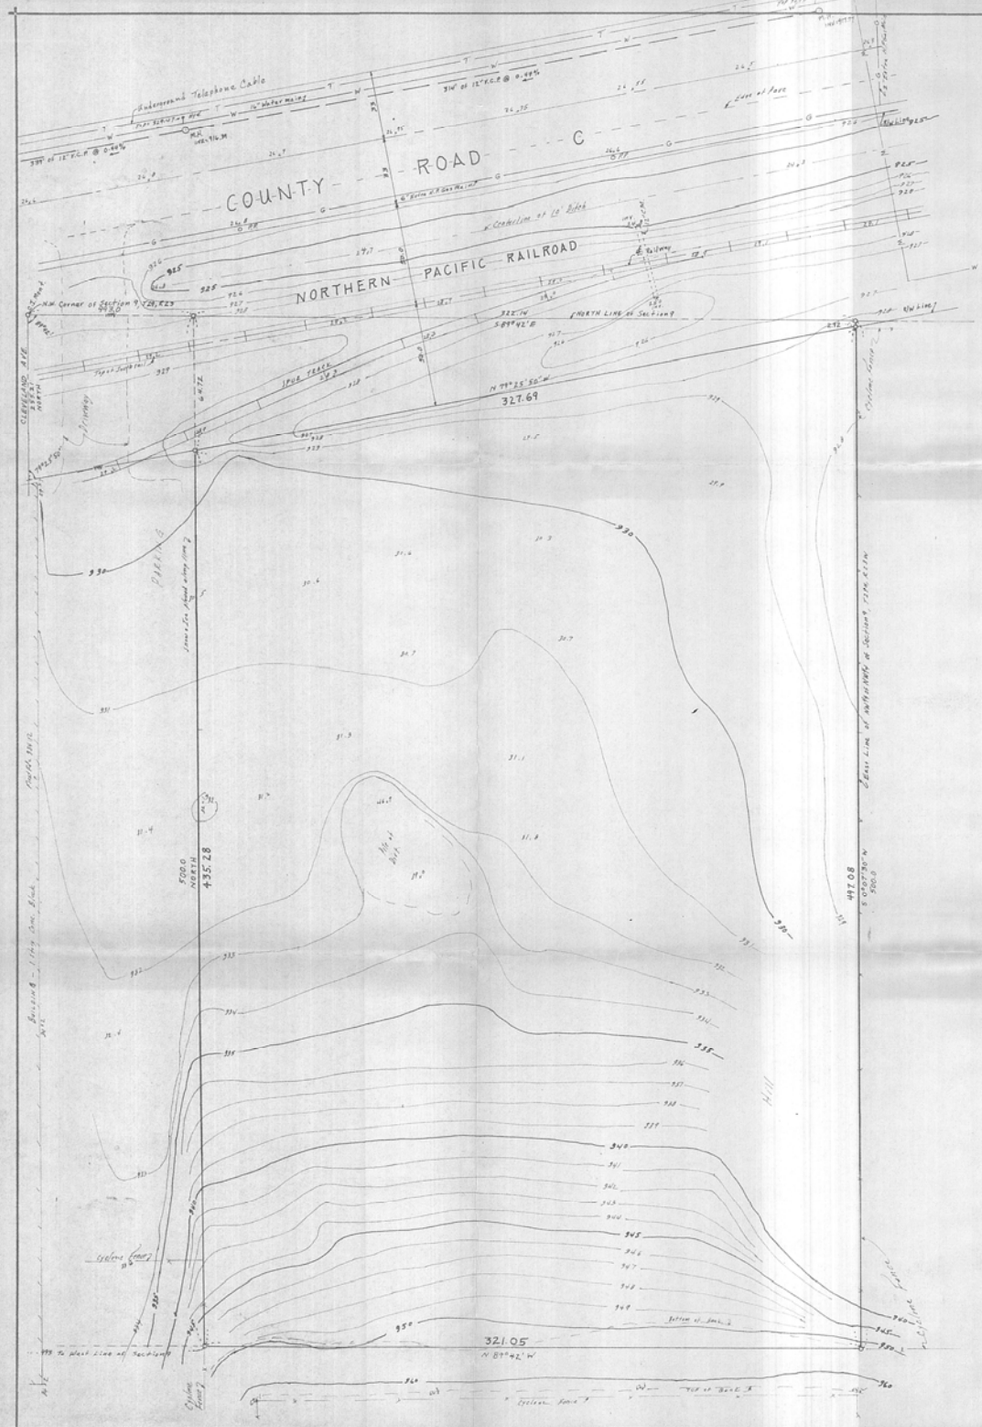

Description

All that part of the North 500 feet of the N.W. ¼ of the N.W. ¼ of Section 9, T29N, R23W, except the West 993 feet thereof lying South of the Southly Right of way of the Northern Pacific Railway.

Contains 103,900 sq. ft., more or less (3.841 acres)

Ramsey County, Minnesota

All elevations are Village Datum & U.S.G.S. Datum
BM - 929.76 Top of Hyd. - Northerly of NE'ly Corner (Shown approx. location)
BM - 929.47 Top of Hyd. - Northerly of NW'ly Corner (" " ")

926 denotes elevation 926.6 where shown
Top of Sold rail of Railway Track are as shown.

Utilities are from public records and the accuracy of same.

I hereby certify that this map shows a survey made by me, or under my direct supervision, and that the corners are correctly placed as shown, and locations and elevations have been correctly shown.

Registered Land Surveyor No. 3960

SITE MAP
Don Rue Property
VILLAGE OF ROSEVILLE
Ramsey County, Minnesota
SCALE 1" = 30'

CHARLES O. GEORGI CORPORATION
CIVIL ENGINEERING AND LAND SURVEYORS
2326 NO. COUNTY ROAD B
ST. PAUL, MINN. 55113

January 1973 - C.H.G.&.S.P. J.Dawinski

I HEREBY CERTIFY THAT THIS PLAN WAS PREPARED BY ME OR UNDER MY DIRECT SUPERVISION AND THAT I AM A DULY REGISTERED ARCHITECT UNDER LAWS OF THE STATE

DATE REG. NO.

BUETOW & ASSOCIATES
ARCHITECTS & ENGINEERS
ST. PAUL, MINNESOTA
CHICAGO, ILLINOIS

NO.	DATE	REVISION