SE 9 29 23

# Certificate of Survey

FROM THE OFFICE OF

## CHARLES O. GEORGI COMPANY

2215 West County Road B — Saint Paul, Minnesota 55113

REGISTERED CIVIL ENGINEER AND LAND SURVEYOR

*I Hereby Certify that* this plat shows a survey made by me of the property described on this plat, and that the corners are correctly placed as shown, and that all locations have been correctly shown.

*Surveyed For* Donald F. Zibell - Attorney

*Date* October 1973

*Scale* 1" = 60'

By Charles O. Georgi

REGISTERED LAND SURVEYOR

*Description:*

The West 1/2 of the SE1/4 of the SE1/4 of the SE1/4 of Section 9, T29N, R23W, except the North 330 feet thereof, and also except the West 198.0 feet thereof; Subject to County Road B and easements of Record.

Contains: 42,820 Sq.Ft., more or less, or 0.983 Acres, more or less. (Area includes Road)
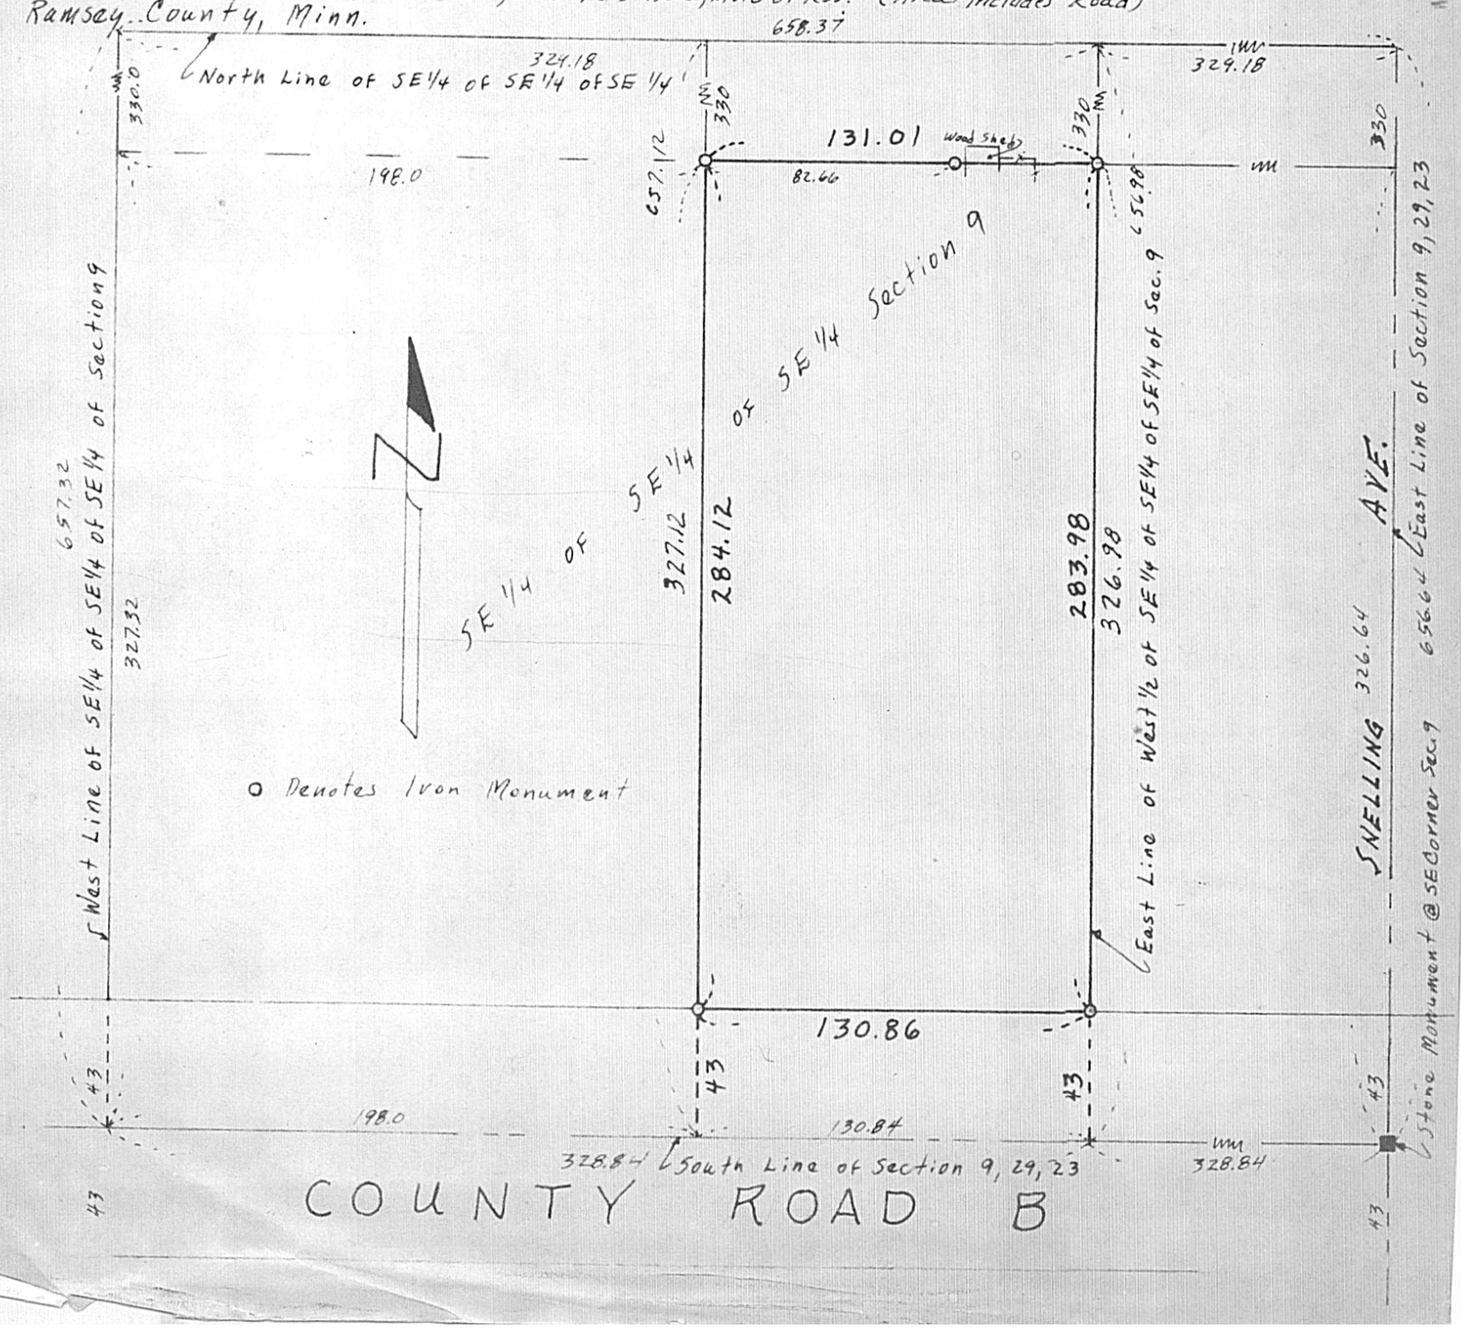
Ramsey County, Minn.