SW 17 29 23

FROM THE OFFICE OF

# CHARLES O. GEORGI COMPANY

2215 West County Road B — Saint Paul, Minnesota 55113

REGISTERED CIVIL ENGINEER AND LAND SURVEYOR

## Certificate of Survey

*I Hereby Certify that* this plat shows a survey made by me of the property described on this plat, and that the corners are correctly placed as shown, and that all locations have been correctly shown. W 1/4 was W 1/2 5/3/73

***Surveyed For*** Reno Rauma

***Date*** April 1973

***Scale*** 1" = 30'

By Charles O. Georgi

REGISTERED LAND SURVEYOR

***Description:***

Subject to Walnut St., and State Trunk Highway #280, the North 48.58 feet of the South 1183.02 feet of that part of the West 1/4 of SW 1/4 of Section 17, T29N, R23W, lying East of Minnesota Transfer Railway Co., 100 Foot R/W.

Ramsey County, Minn.

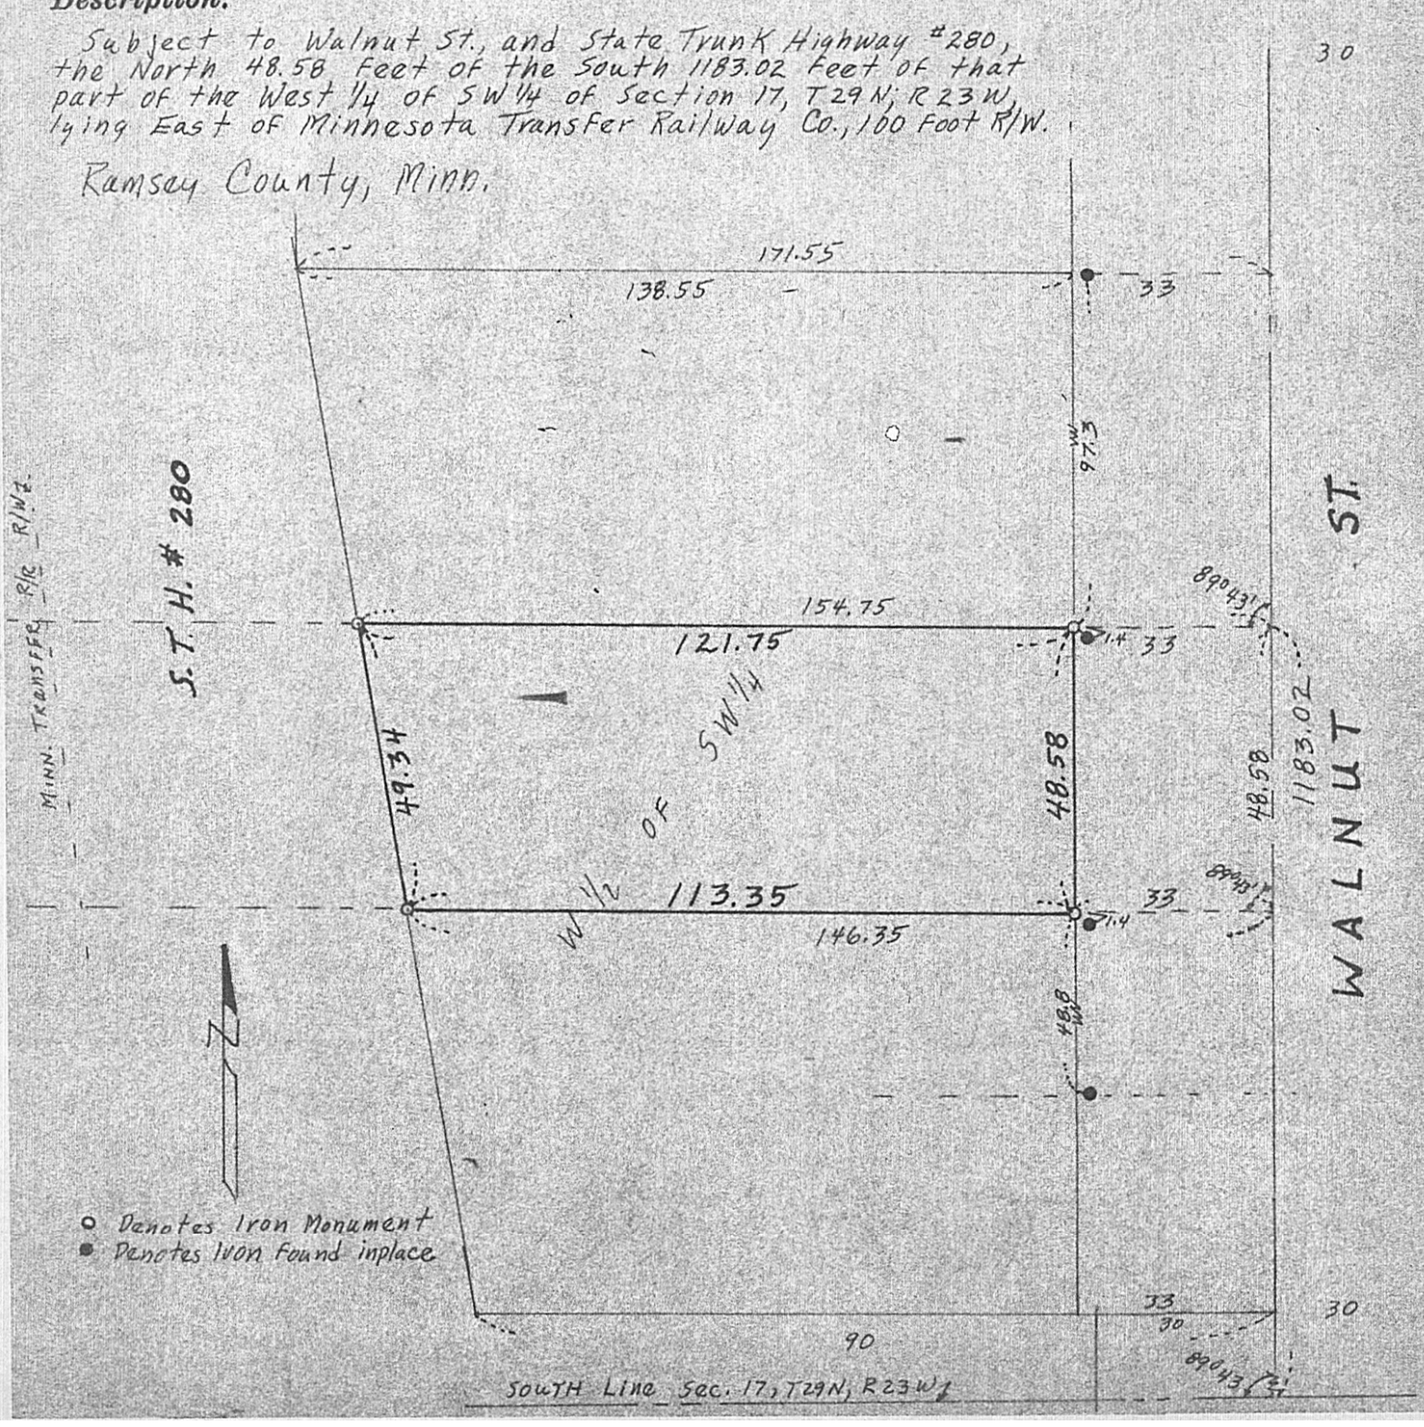


o Denotes Iron Monument

● Denotes Iron Found inplace