NW 363023

FROM THE OFFICE OF

CHARLES O. GEORGI COMPANY

2215 West County Road B — Saint Paul, Minnesota 55113

REGISTERED CIVIL ENGINEER AND LAND SURVEYOR

Certificate of Survey

I Hereby Certify that **this plat shows a survey made by me of the property described on this plat, and that the corners are correctly placed as shown, and that all locations have been correctly shown.** 7/27/73 Revise parcel and descriptions

Surveyed For Mrs. Chandler - Keller Corp. Realtor

Date July 1973

Scale 1" = 100'

By Charles O. Georgi
REGISTERED LAND SURVEYOR

Description:

The South 125 feet of the North 840 feet of Tract A, Registered Land Survey No 35 except the East 650 feet thereof, Ramsey County, Minn. Subject to Chandler Road
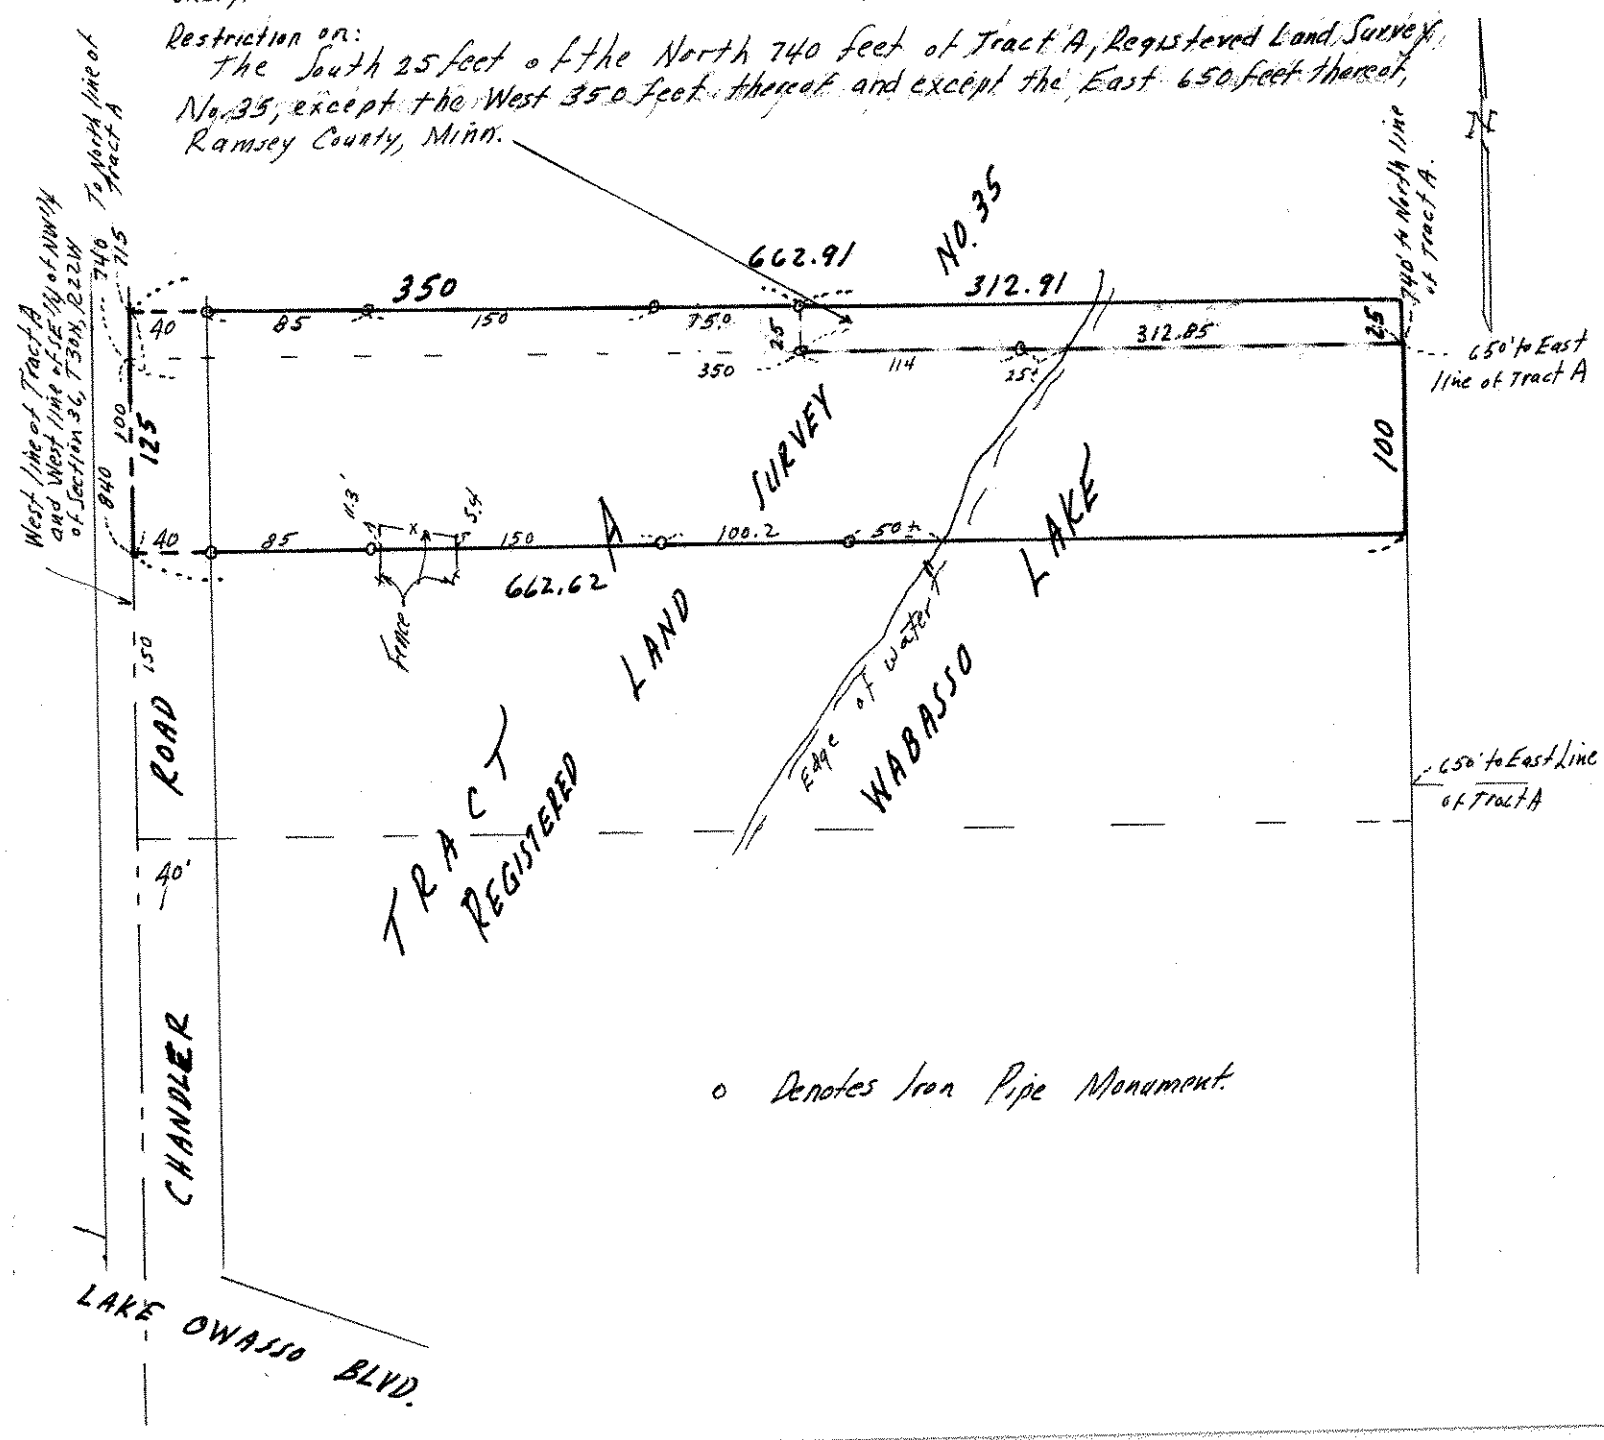
Restriction on:
The South 25 feet of the North 740 feet of Tract A, Registered Land Survey No. 35, except the West 350 feet thereof and except the East 650 feet thereof, Ramsey County, Minn.