SE 8 2922

FROM THE OFFICE OF

CHARLES O. GEORGI COMPANY

2215 West County Road B Saint Paul, Minnesota 55113

REGISTERED CIVIL ENGINEER AND LAND SURVEYOR

Certificate of Survey

I Hereby Certify that **this plat shows a survey made by me of the property described on this plat, and that the corners are correctly placed as shown, and that all locations have been correctly shown.**

Surveyed For Carl Pedro

Date August 1973

Scale 1" = 50'

By Charles O. Georgi
REGISTERED LAND SURVEYOR

Description:
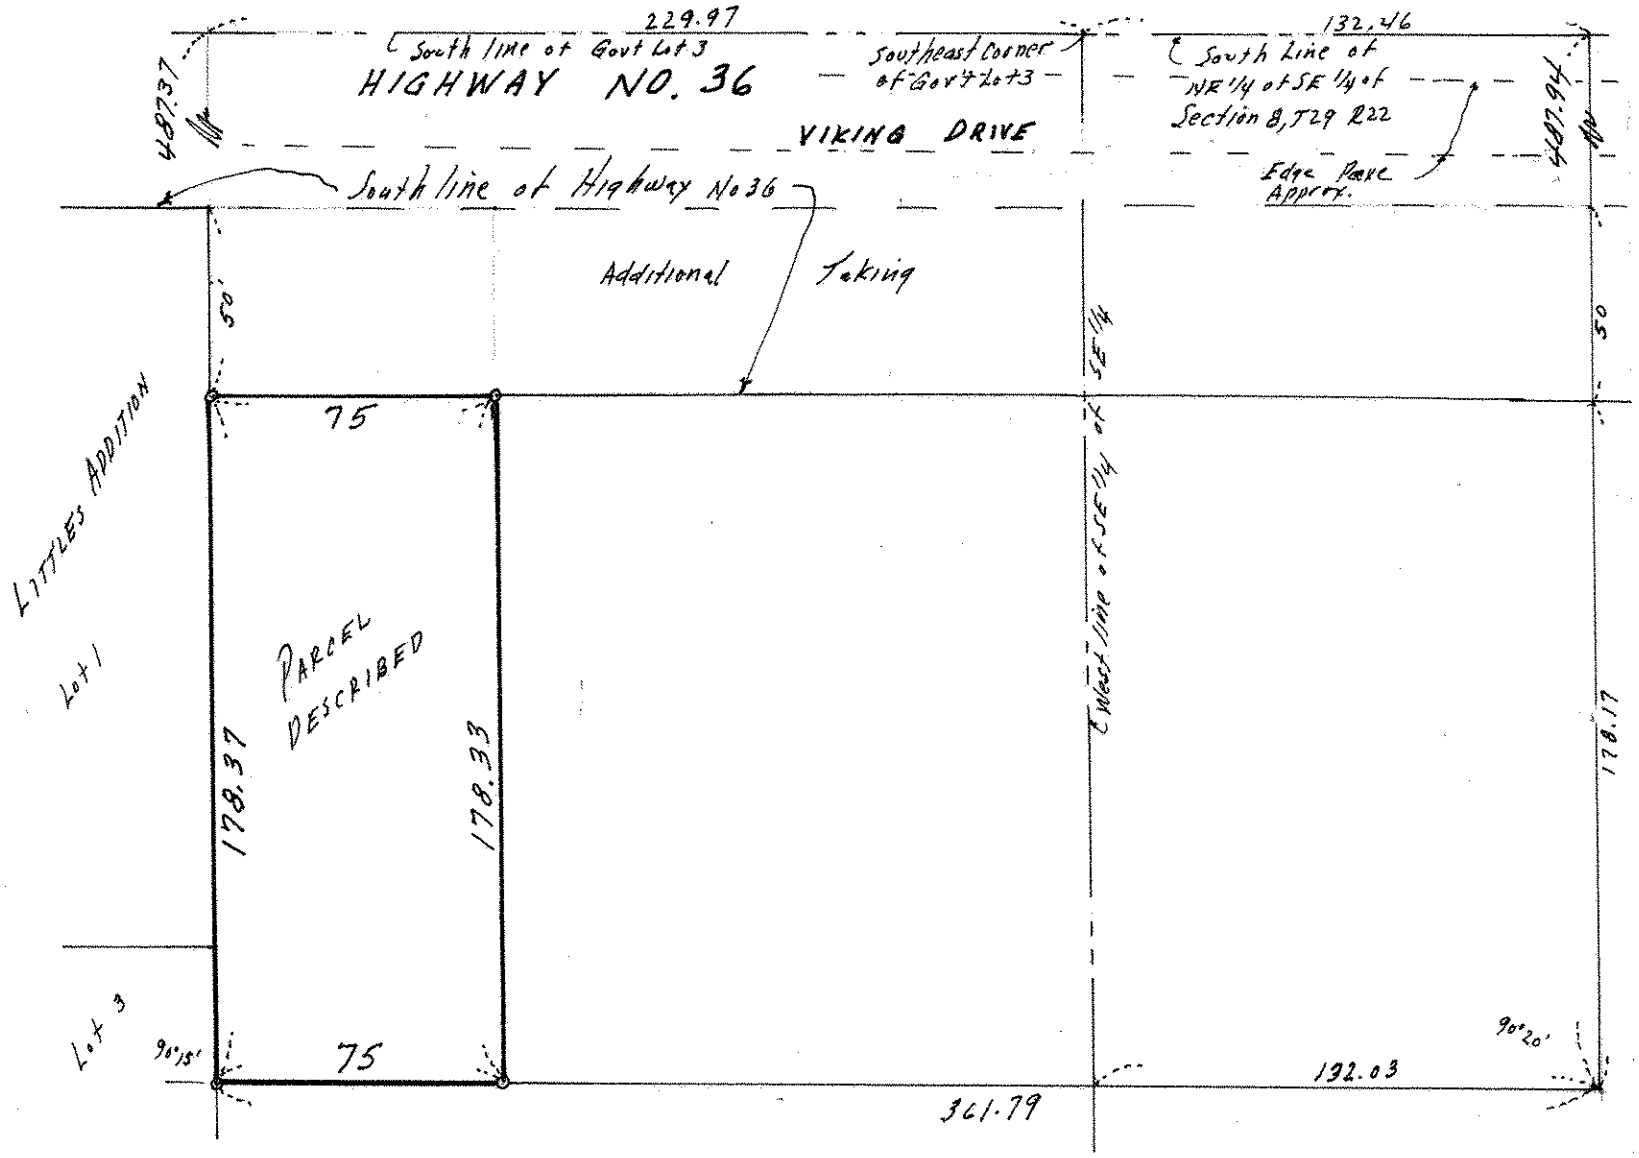
The West 75 feet of the following described parcel of land:
Commencing at the Southeast corner of Govt Lot 3, thence East on the South line of the NE 1/4 of the SE 1/4 of Section 8, 132.46 feet thence South 487.94 feet to a point 132.03 feet East of the West line of the SE 1/4 of the SE 1/4 of Section 8, thence West parallel to the South line of Section 8 361.79 feet, thence North 487.37 feet to the South line of Govt Lot 3, thence East on said South line 229.97 feet to the place of beginning. All being in Section 8, T29, R22. Except part taken for Highway purposes.