FROM THE OFFICE OF

Certificate of Survey

Description: Lot 9, Block 1,

CHARLES O. GEORGI COMPANY

2215 West County Road B

Saint Paul, Minnesota 55113

REGISTERED CIVIL ENGINEER AND LAND SURVEYOR


I Hereby Certify that this plat shows a survey made by me of the property described on this plat, and that the corners are correctly placed as shown, and that all locations have been correctly shown.

Surveyed For Fred Zamzow

Date October 1923

By Marky O. Johnson

REGISTERED LAND SURVEYOR

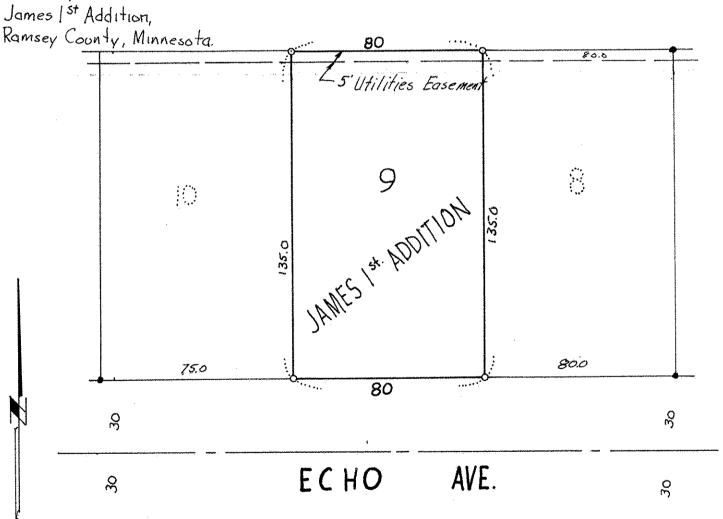

- odenotes iron pipe monuments
- · denotes iron pipe monuments found in place.