SE 34 29 22

FROM THE OFFICE OF

CHARLES O. GEORGI COMPANY

2215 West County Road B Saint Paul, Minnesota 55113

REGISTERED CIVIL ENGINEER AND LAND SURVEYOR

Certificate of Survey

I Hereby Certify that **this plat shows a survey made by me of the property described on this plat, and that the corners are correctly placed as shown, and that all locations have been correctly shown.**

Surveyed For Sheryl Y. Luth

Date December 1973

Scale 1" = 40'

By Charles O. Georgi
REGISTERED LAND SURVEYOR

Description:

All that part of the East 53 feet of the West 103 feet of tract E, Registered Land Survey No. 9, except the North 117.27 feet thereof, described as follows:

beginning at the Northeast corner of above said parcel of land, thence Southwesterly 117.1 feet, more or less, to a point on the South line of said tract E distant 8.5 feet West of the Southeast corner of above said parcel and there terminating.
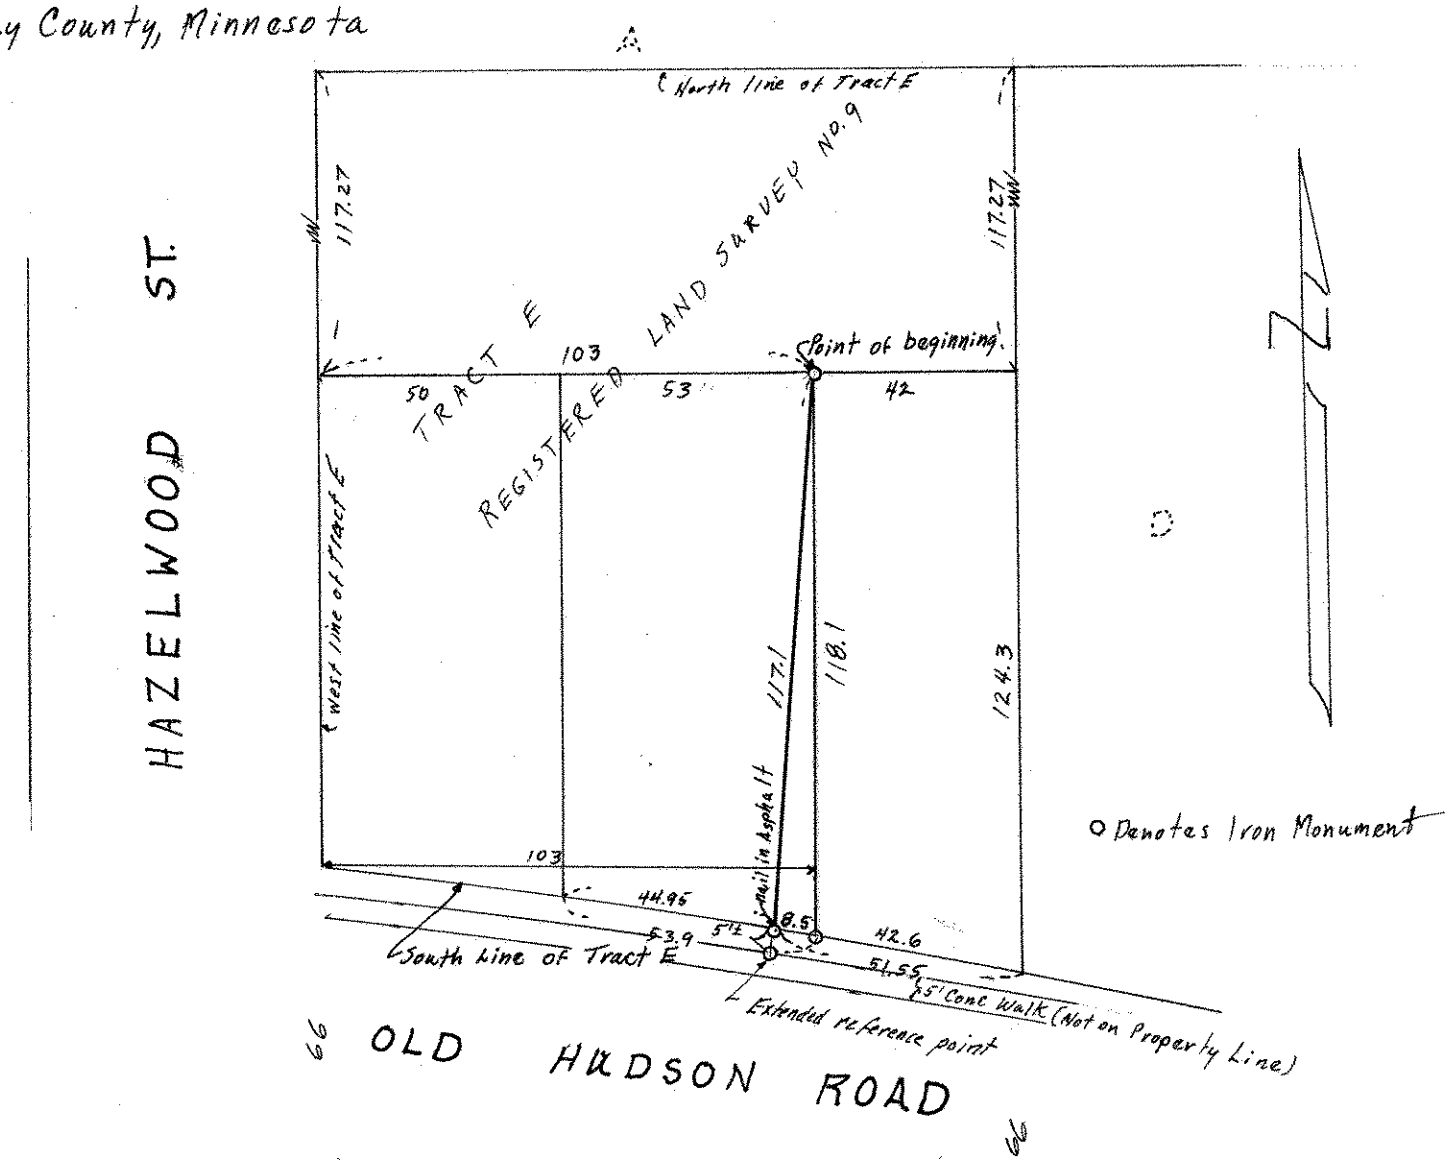
Ramsey County, Minnesota