NE 7 29 22

FROM THE OFFICE OF

CHARLES O. GEORGI COMPANY

2215 West County Road B Saint Paul, Minnesota 55113

REGISTERED CIVIL ENGINEER AND LAND SURVEYOR

Certificate of Survey

For: Ted Glasrud Associates

I Hereby Certify that this plat shows a building location survey made by me on the property described on this plat, and that all locations, have been correctly shown. There is no encroachment of the building onto the pipe line Easement to the Southwest.

Date July 1973

Scale 1" = 100'

By Charles O. Georgi
REGISTERED LAND SURVEYOR
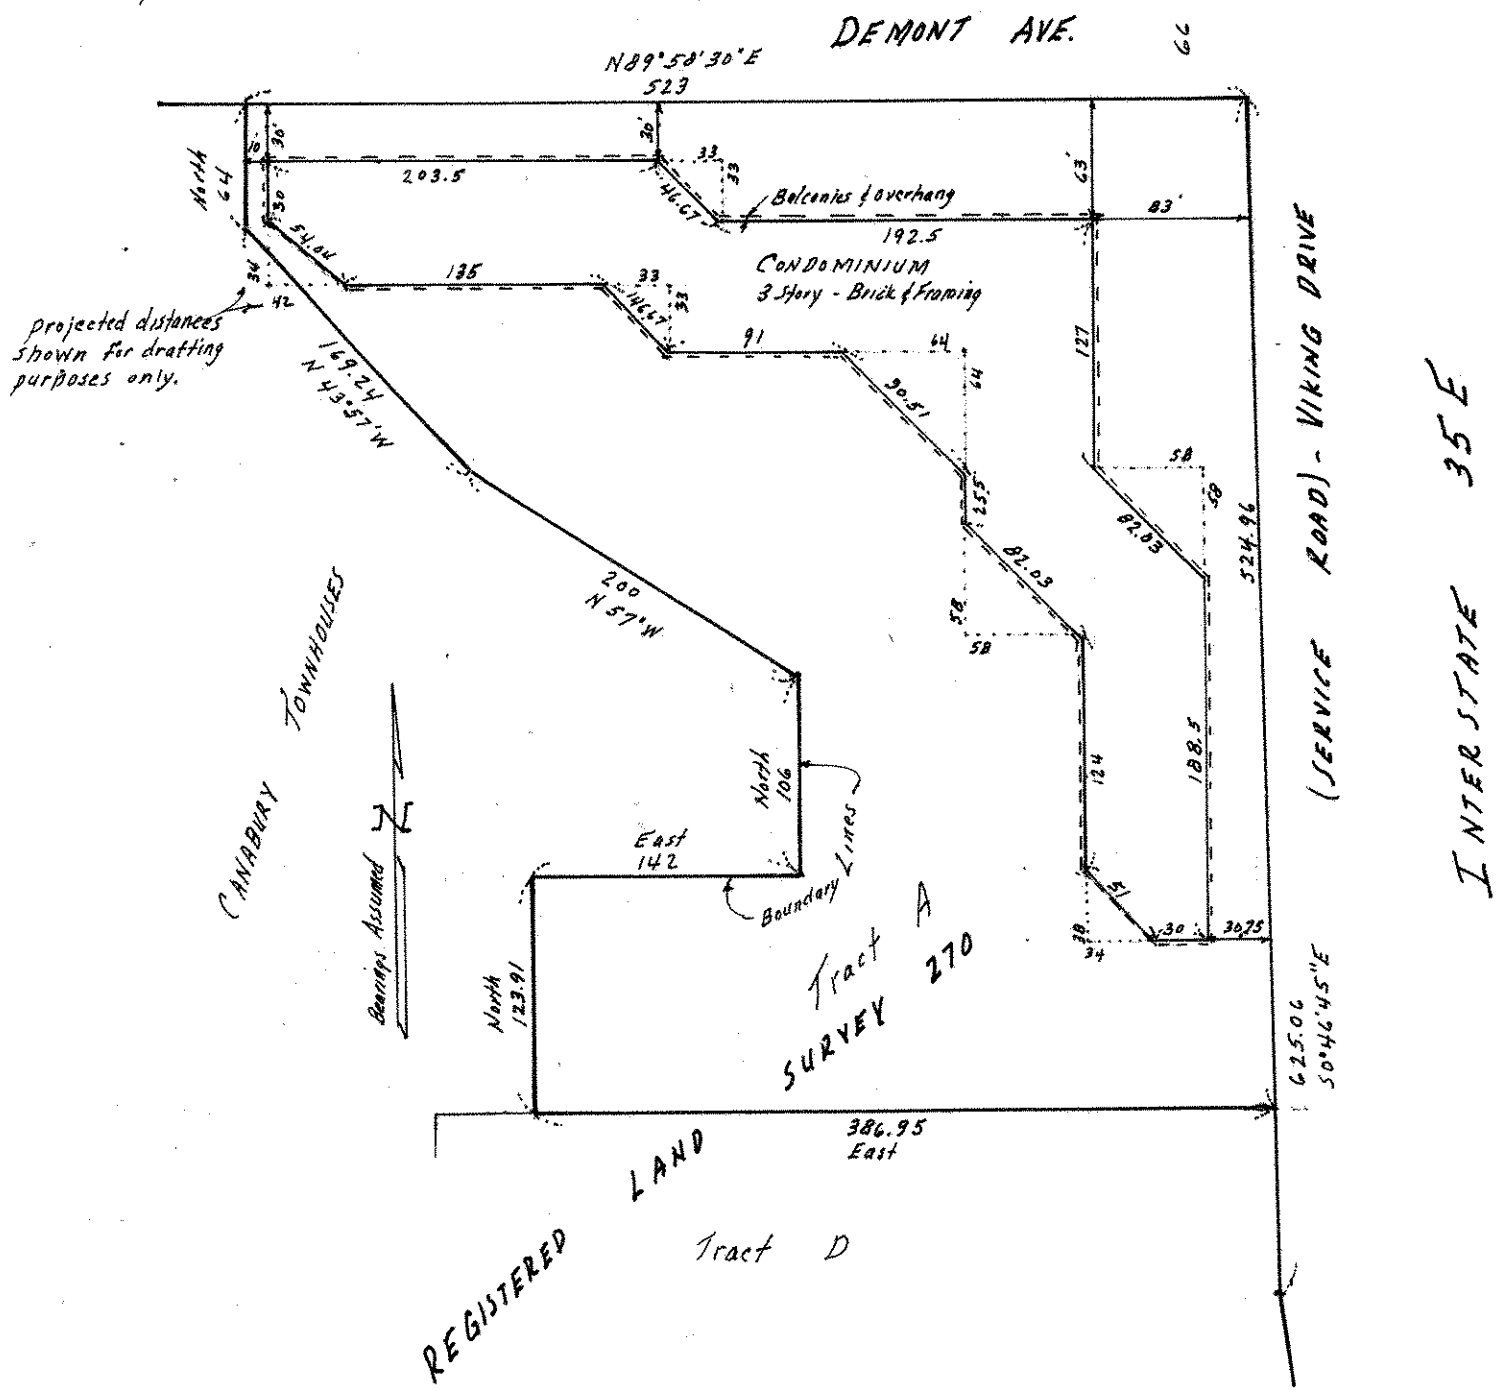
Description:
Tract A, Registered Land Survey No. 270,
Ramsey County, Minn.
Subject to easements of record.