FROM THE OFFICE OF

Certificate of Survey

CHARLES O. GEORGI COMPANY

2215 West County Road B

Saint Paul, Minnesota 55113

REGISTERED CIVIL ENGINEER AND LAND SURVEYOR

I Hereby Certify that this plat shows a survey made by me of the property described on this plat, and that the corners are correctly placed as shown, and that all locations have been correctly shown.

Surveyed For Shery! Y. Luth

Date December 1973

By Marly O. Schrige
RECISTERED LAND SURVEYOR

Description:


All that part of the East 53 feet of the West 103 feet of tract E, Registered Land Survey No. 9, except the North 117.27 feet thereof, described as Follows:

beginning at the Northeast corner of above said parcel of land thence Southwesterly 117.1 feet, more or less, to a point on the South line of said tract E distant 8.5 feet West of the Southeast corner of above said parcel and there terminating.

Ramsey County, Minnesota

51

JZW

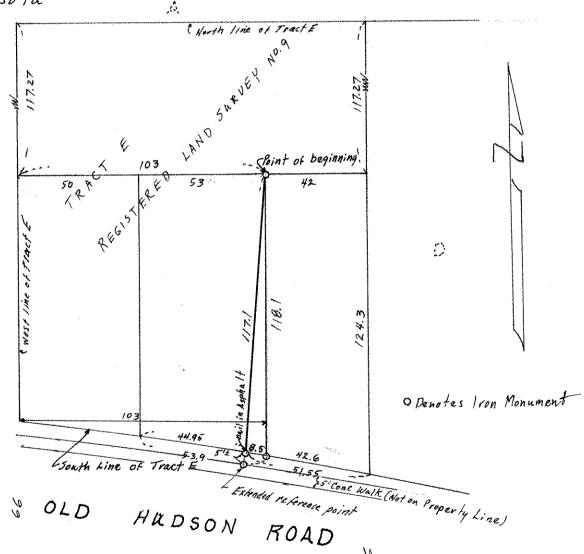

V.