


111 4TH AVE. SE  
ST. CLOUD, MINN.  
251-7751

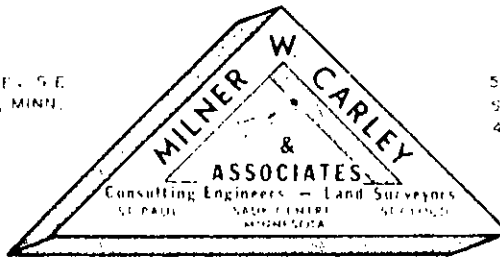


500 W HWY 96  
ST PAUL 12, MINN.  
484-3301

314 OAK ST., SAUK CENTRE, MINN 352-3664

I hereby certify that this Certificate of Survey  Description  Easement  Plan  or Specification  was prepared by me or under my direct supervision and that I am a duly Registered Land Surveyor  Professional Engineer  under the laws of the State of Minnesota.

*Donald W. Carley*

Reg. No. 3527 Date July 3, 1973

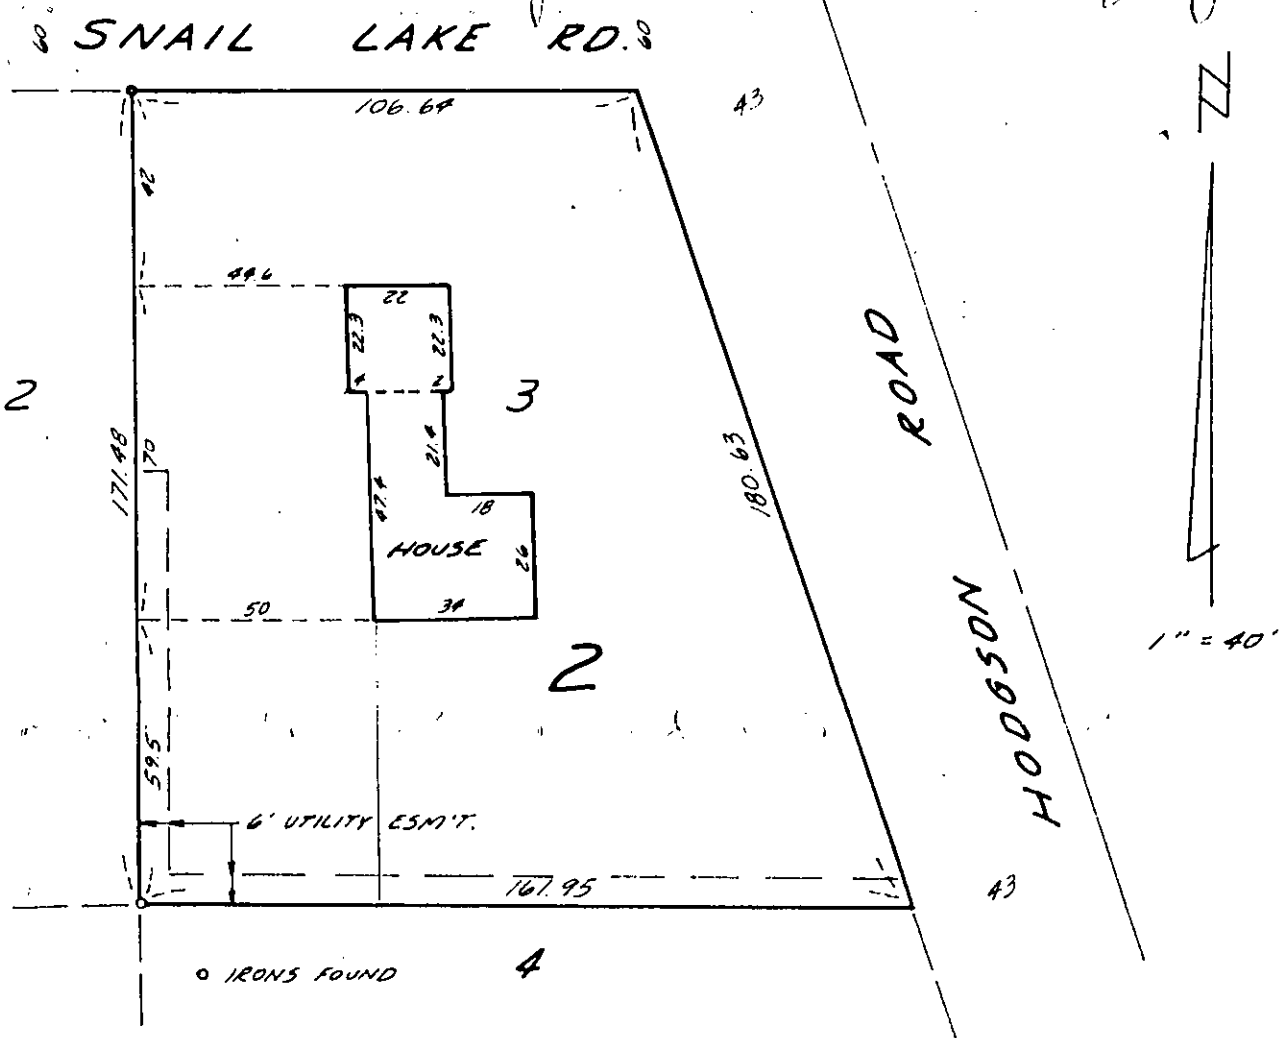

MORTGAGE LOAN SURVEY

Lot 3, Block 2  
BLAINE OAKS, Ramsey County, Minn.

73-245  
459-75