N.W. 2,28,23

FROM THE OFFICE OF

CHARLES O. GEORGI COMPANY

2215 West County Road B — Saint Paul, Minnesota 55113

REGISTERED CIVIL ENGINEER AND LAND SURVEYOR

Certificate of Survey

Project No. Minn. A-1-1
Parcel No. 148-C
Area. 3539 sqft Mol.

I Hereby Certify that **this plat shows a survey made by me of the property described on this plat, and that the corners are correctly placed as shown, and that all locations have been correctly shown.**

Surveyed For Housing Authority

Date April 1973

Scale 1" = 40'

By Charles O. Georgi
REGISTERED LAND SURVEYOR

Description:

Lot 28, Block 5, Rogers' Addition to St. Paul, except the West 28 feet thereof, Ramsey County, Minnesota.

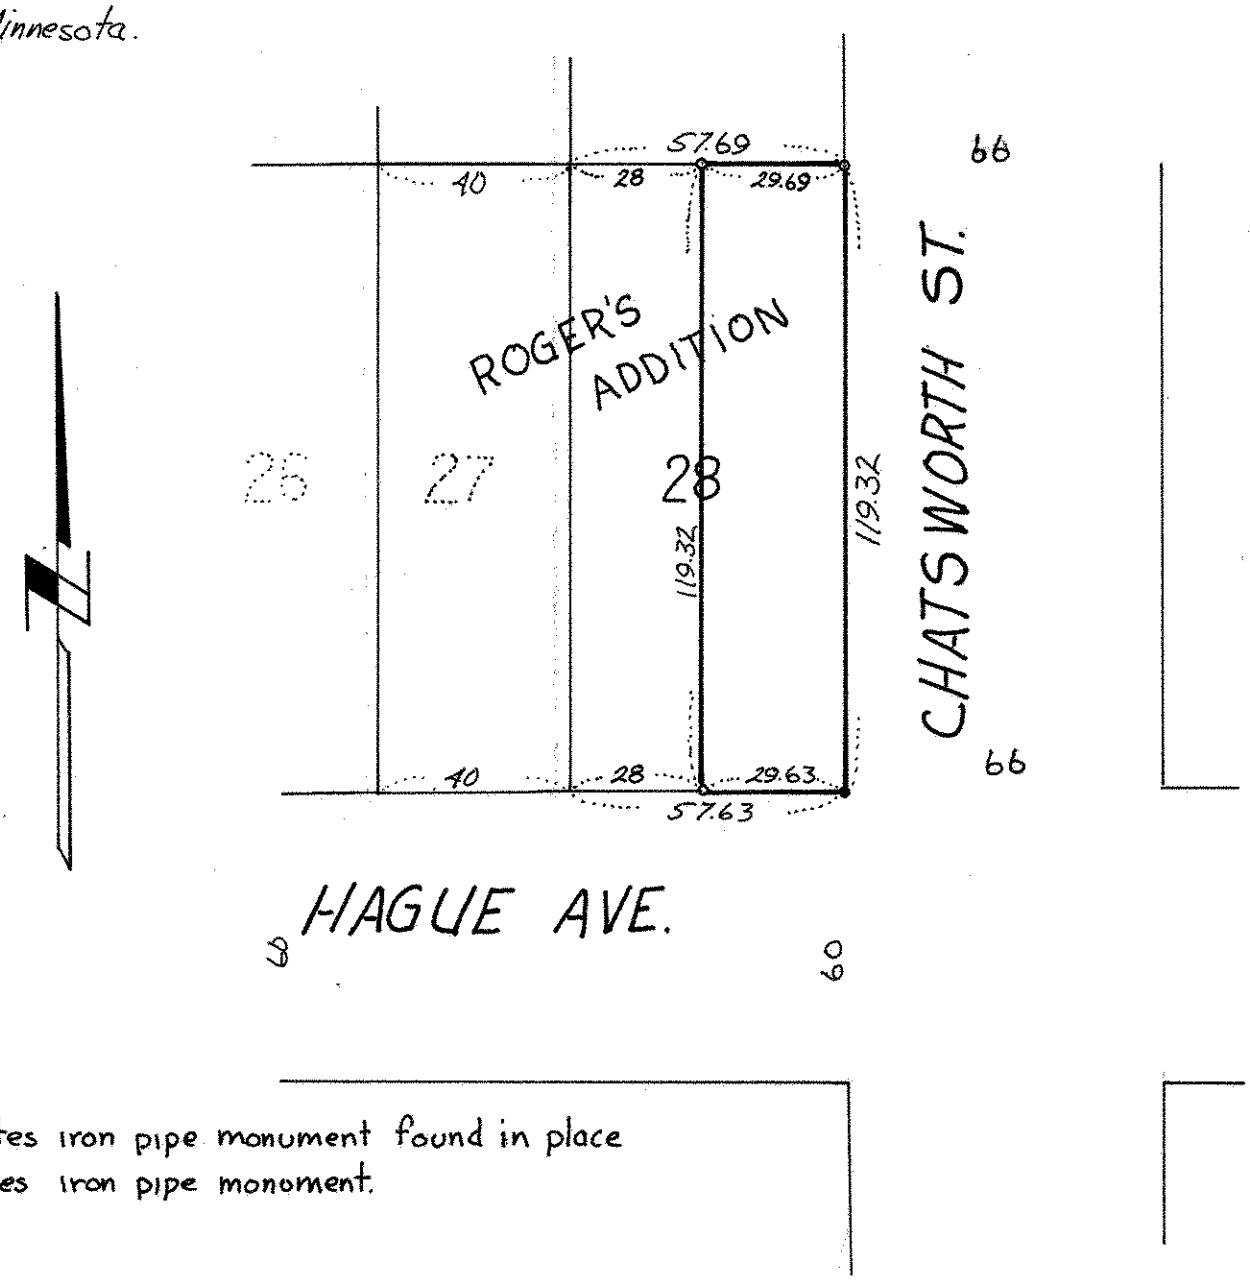

• denotes iron pipe monument found in place
o denotes iron pipe monoment.