NE. 2 28 23

FROM THE OFFICE OF

CHARLES O. GEORGI COMPANY

2215 West County Road B Saint Paul, Minnesota 55113

REGISTERED CIVIL ENGINEER AND LAND SURVEYOR

Certificate of Survey

Project No. Minn A-1-1
Parcel No. 197-E
Area. 4,200 sq. ft. m.o.l.

I Hereby Certify that **this plat shows a survey made by me of the property described on this plat, and that the corners are correctly placed as shown, and that all locations have been correctly shown.**

Surveyed For Housing Authority
Date June 1973
Scale 1" = 30'

By Charles O. Georgi
REGISTERED LAND SURVEYOR
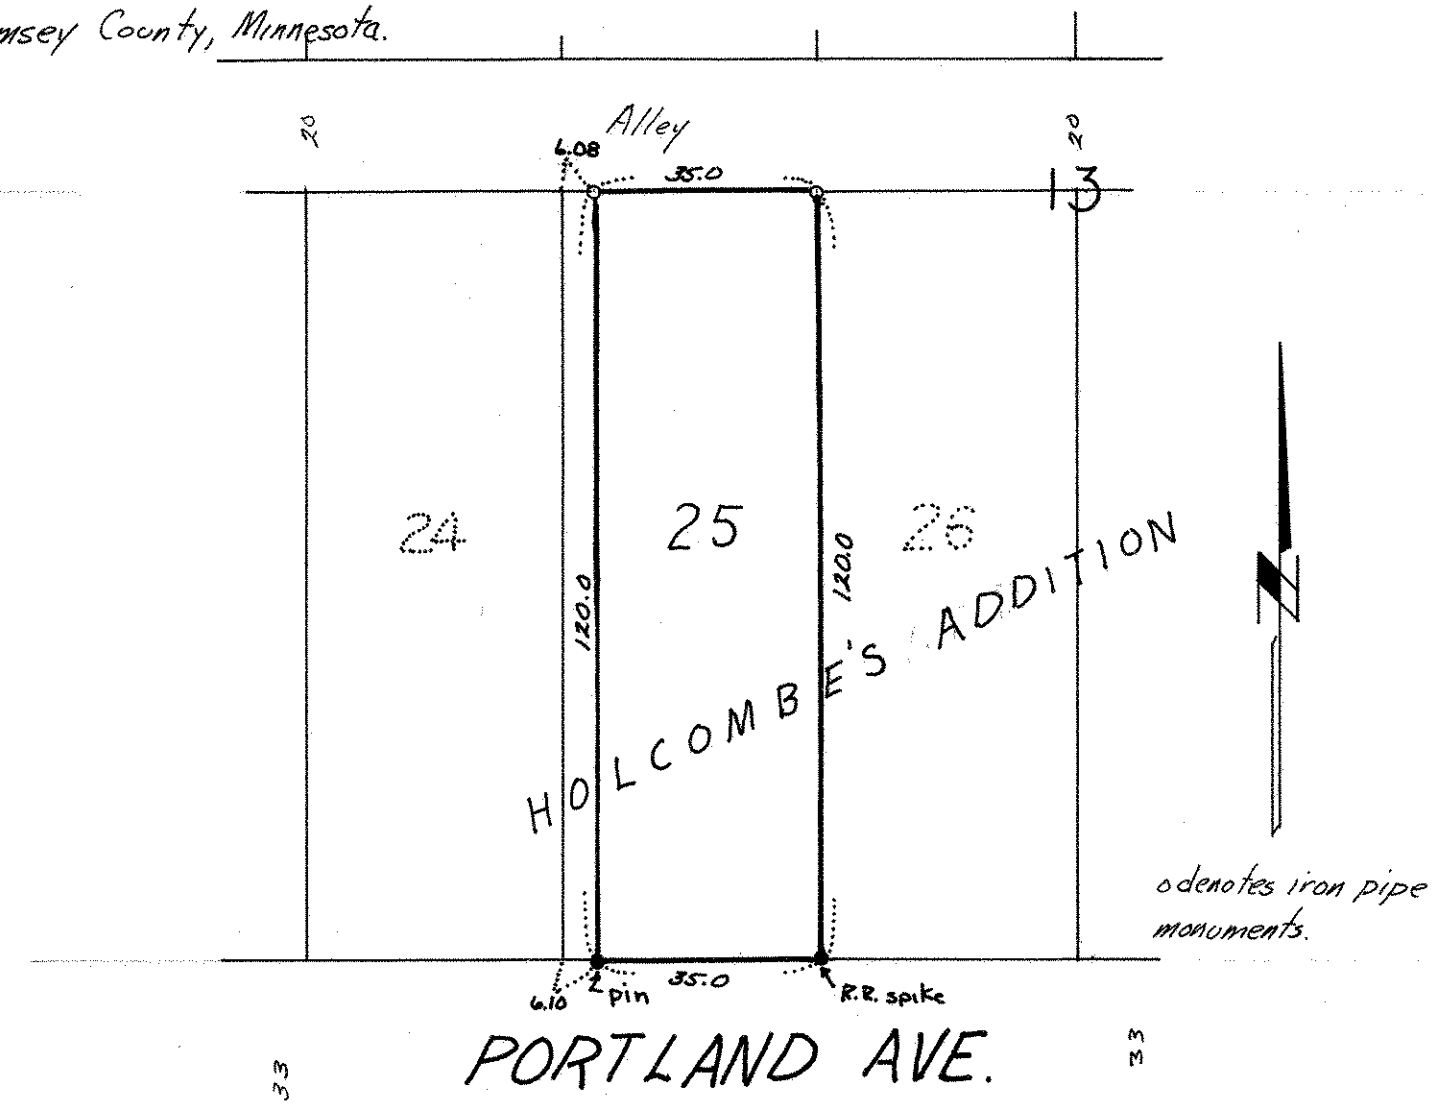
Description:
The East 35.0 feet of Lot 25, Block 13, Holcombe's Addition
Ramsey County, Minnesota.