SE 1 28 23

FROM THE OFFICE OF

CHARLES O. GEORGI COMPANY

2215 West County Road B Saint Paul, Minnesota 55113

REGISTERED CIVIL ENGINEER AND LAND SURVEYOR

Certificate of Survey

Project No. Minn A-1-7
Parcel No. 29-B
Area: 5250 Sq. Ft., m.o.l.

I Hereby Certify that **this plat shows a survey made by me of the property described on this plat, and that the corners are correctly placed as shown, and that all locations have been correctly shown.** Parcel Divided 29-B1, 29-B2

Surveyed For Housing Authority

Date June 1973

Scale 1" = 40'

By Charles O. Georgi
REGISTERED LAND SURVEYOR

Description:
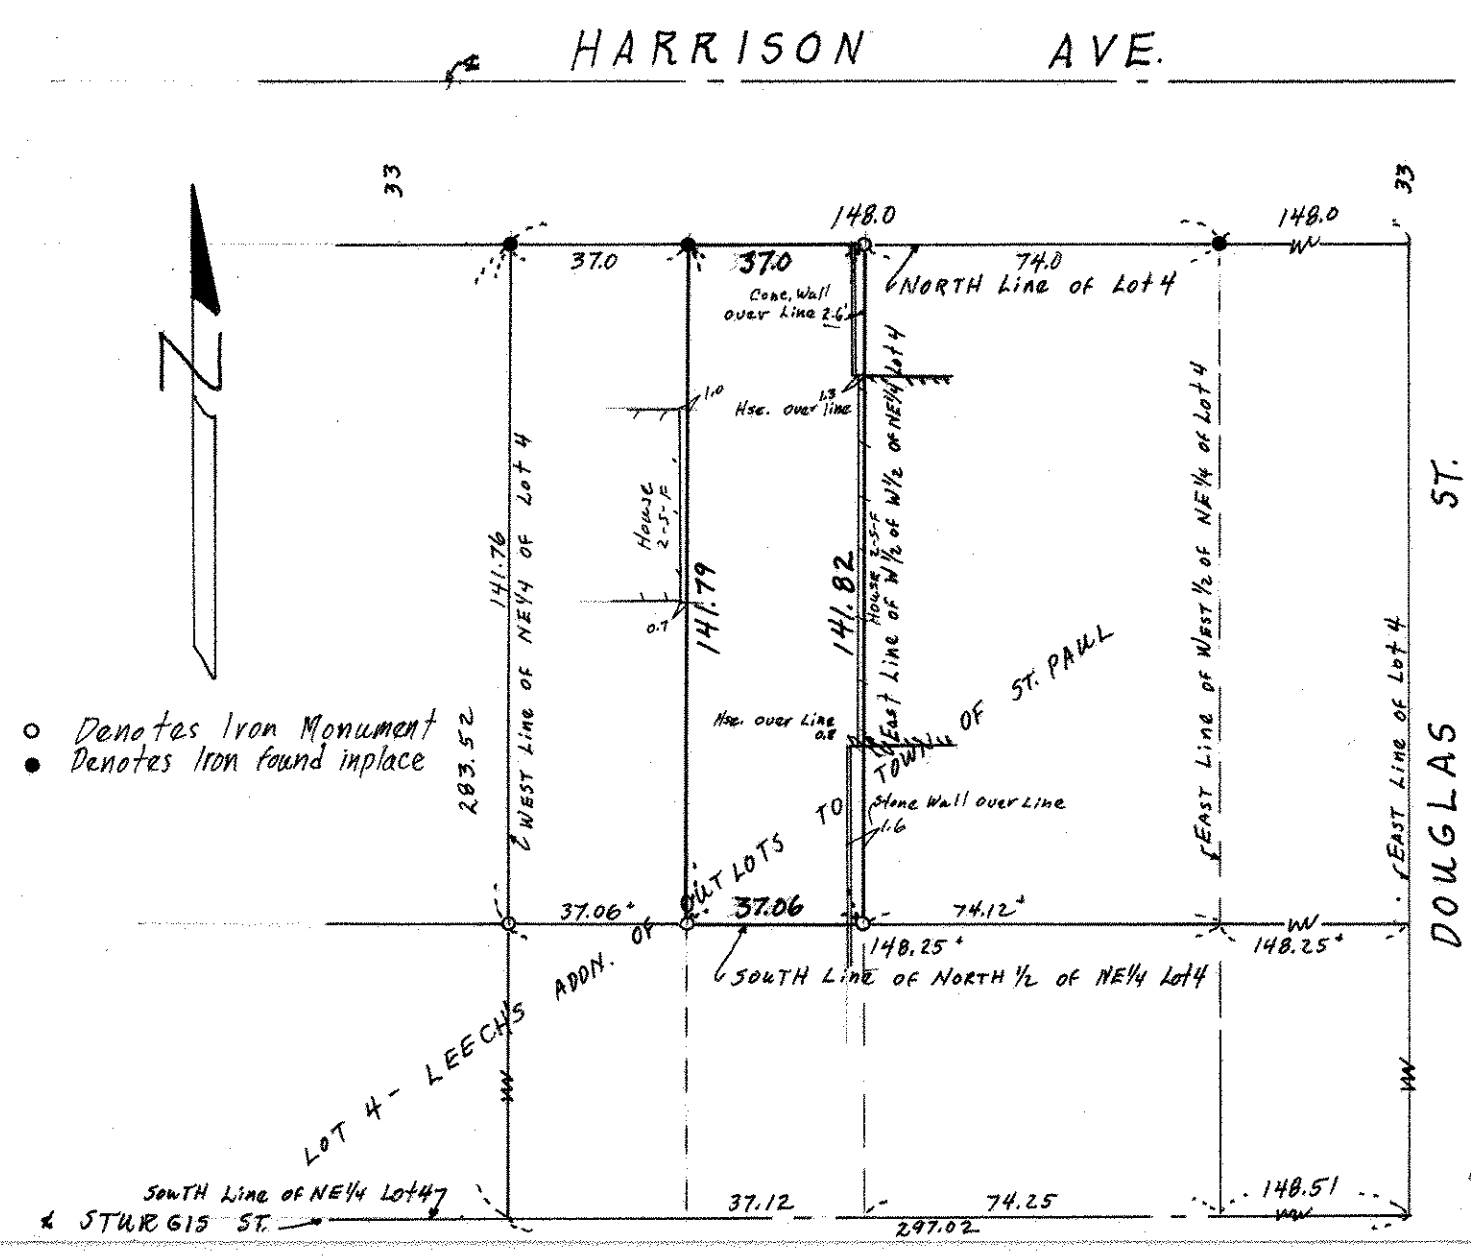
The East ½ of West ½ of the West ½ of the North ½ of NE¼, lot 4, Leech's Addition of Out Lots to the Town of St. Paul, Ramsey County, Minn.