SE 1 28 23

FROM THE OFFICE OF

CHARLES O. GEORGI COMPANY

2215 West County Road B Saint Paul, Minnesota 55113

REGISTERED CIVIL ENGINEER AND LAND SURVEYOR

Certificate of Survey

Project No. Minn. A-1-7
Parcel No. W7-4
Area = 8,295 Sq. Ft. m.l.

I Hereby Certify that this plat shows a survey made by me of the property described on this plat, and that the corners are correctly placed as shown, and that all locations have been correctly shown.

Surveyed For Housing Authority

Date January 1973

Scale 1" = 60'

By Charles O. Georgi
REGISTERED LAND SURVEYOR

#287 Sturgis

Description:

The South ½ of the West ½ of the West ½ of the NE¼ of Lot 4, Leech's Addition of Out Lots to the Town of St. Paul, except Street. Ramsey County, Minnesota
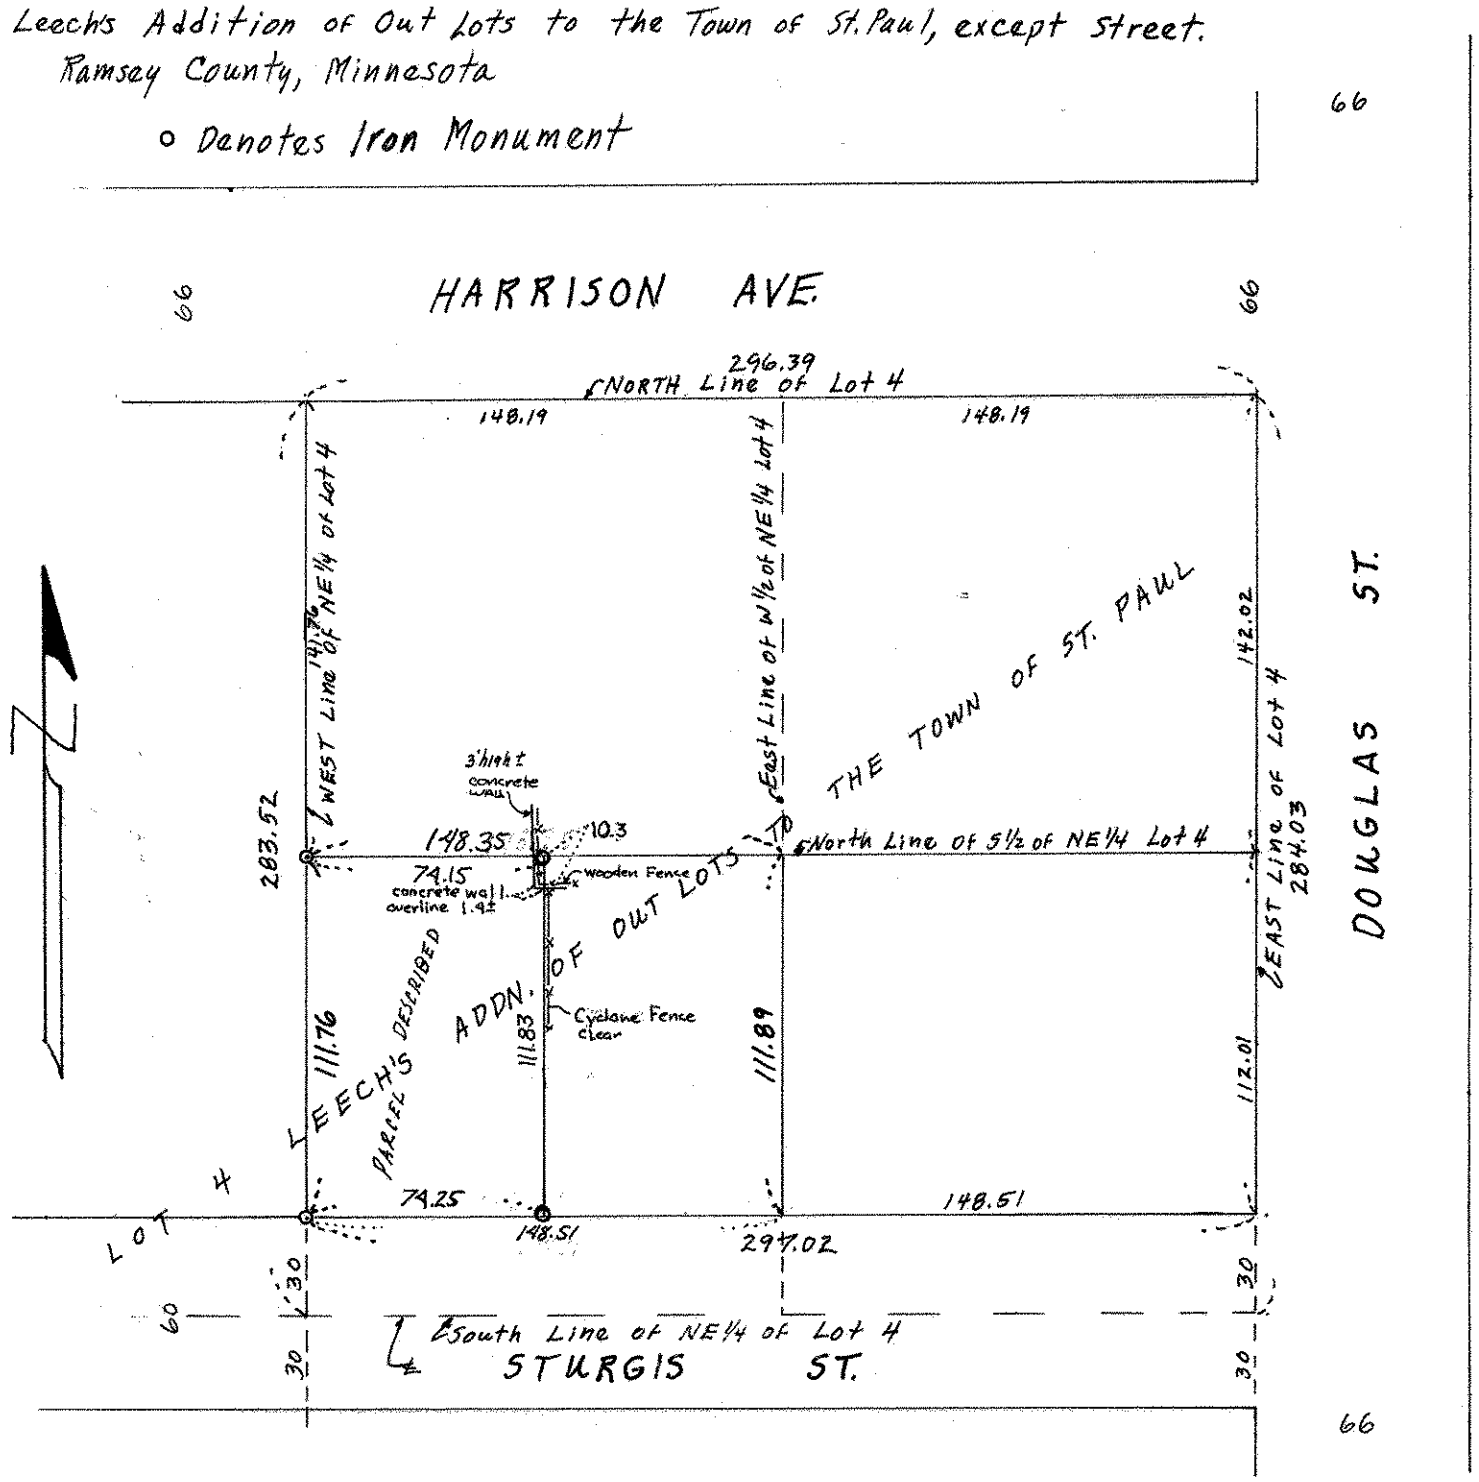
o Denotes Iron Monument