S.W. 1 28,23,

FROM THE OFFICE OF

CHARLES O. GEORGI COMPANY

2215 West County Road B Saint Paul, Minnesota 55113

REGISTERED CIVIL ENGINEER AND LAND SURVEYOR

Certificate of Survey

Project No. Minn A-1-7
Parcel No. 47-C
Area. 4,797 sq.ft.

I Hereby Certify that **this plat shows a survey made by me of the property described on this plat, and that the corners are correctly placed as shown, and that all locations have been correctly shown.**

Surveyed For Housing Authority
Date March 1973
Scale 1" = 40

By Charles O. Georgi
REGISTERED LAND SURVEYOR
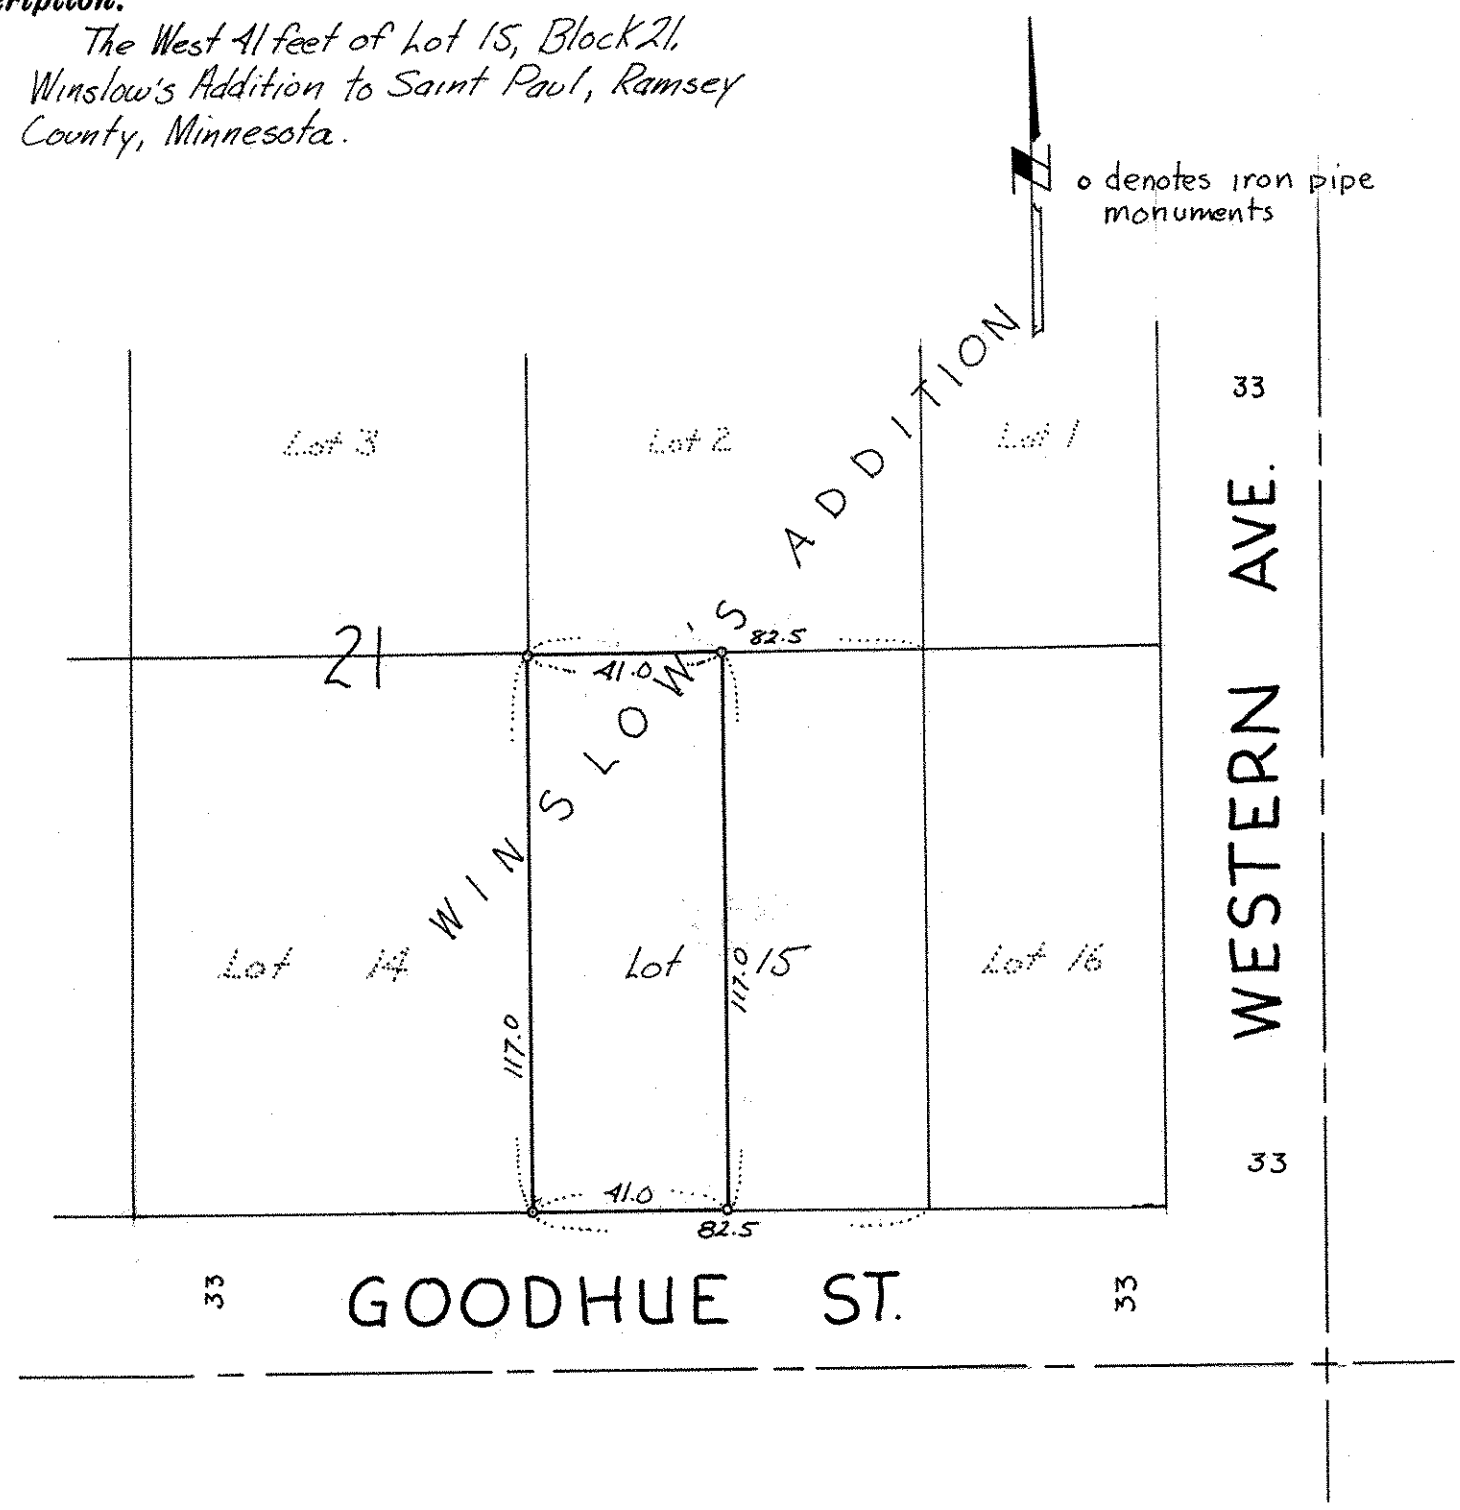
Description:
The West 41 feet of Lot 15, Block 21, Winslow's Addition to Saint Paul, Ramsey County, Minnesota.