NW 11 28 23

FROM THE OFFICE OF

CHARLES O. GEORGI COMPANY

2215 West County Road B Saint Paul, Minnesota 55113

REGISTERED CIVIL ENGINEER AND LAND SURVEYOR

Certificate of Survey

Project No.- Minn. A-1-7
Parcel No. - 147-A
Area - 5077 Sq. Ft.

I Hereby Certify that **this plat shows a survey made by me of the property described on this plat, and that the corners are correctly placed as shown, and that all locations have been correctly shown.**

Surveyed For Housing Authority

Date January 1973

Scale 1" = 40'

By Charles O. Georgi
REGISTERED LAND SURVEYOR

937 Palace Ave

Description:
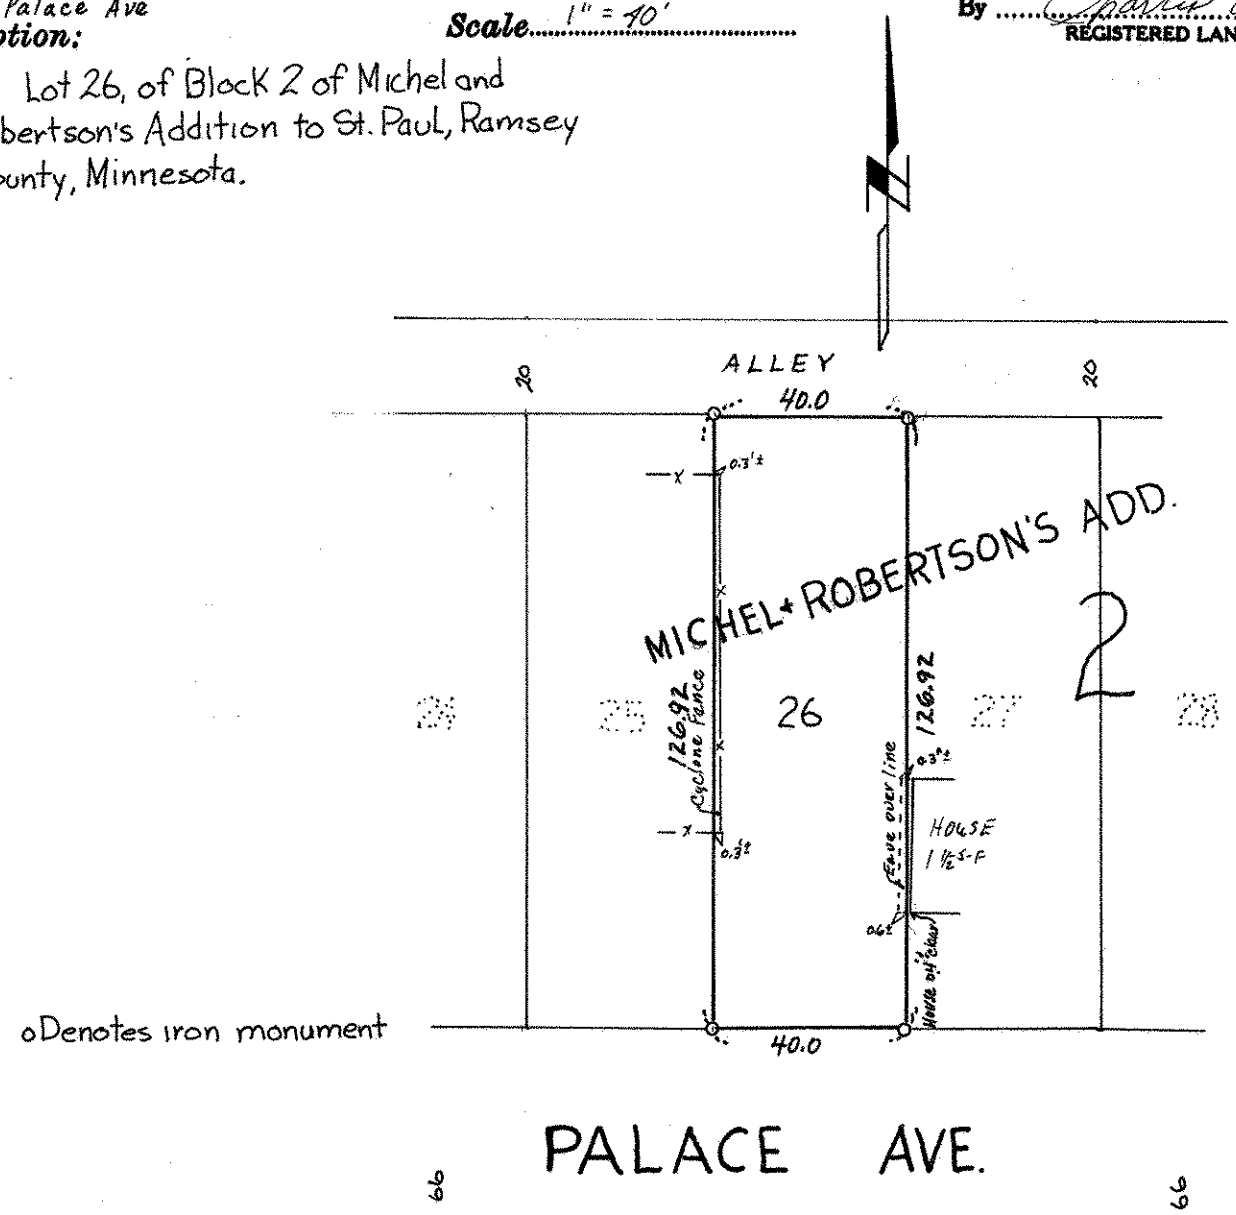
Lot 26, of Block 2 of Michel and Robertson's Addition to St. Paul, Ramsey County, Minnesota.