

SW 11, 28, 23

FROM THE OFFICE OF

CHARLES O. GEORGI COMPANY

2215 West County Road B

Saint Paul, Minnesota 55113

REGISTERED CIVIL ENGINEER AND LAND SURVEYOR

Certificate of Survey

I Hereby Certify that this plat shows a survey made by me of the property described on this plat, and that the corners are correctly placed as shown, and that all locations have been correctly shown.

Project No. Minn A-1-7
Parcel No 189-A
Area 1205 sq. ft. m.o.l.

Surveyed For Housing Authority


Date May 1973

Scale 1"=30'

By Charles O. Georgi
REGISTERED LAND SURVEYOR

Description:

The East 10 feet of Lot 12, Block A,
Watsons Addition to St. Paul, Ramsey
County, Minnesota.

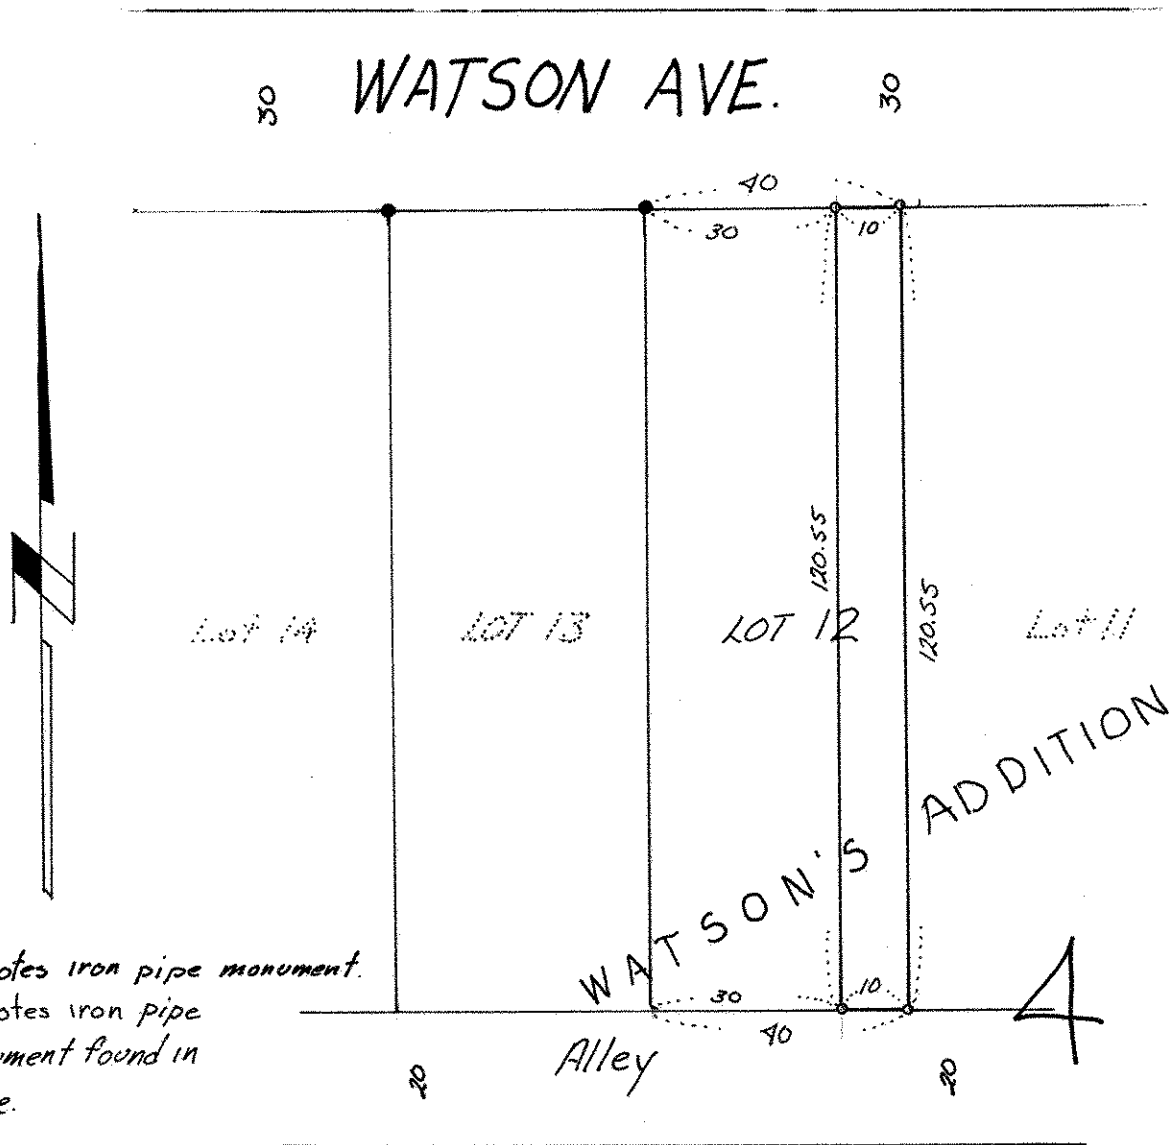

o denotes iron pipe monument.
• denotes iron pipe monument found in place.