Certificate of Survey

Project No. Minn A-1-7
Parcel No 31-B
Area. 4,686 sq.ff.

Description:

CHARLES O. GEORGI COMPANY

2215 West County Road B

Saint Paul, Minnesota 55113

REGISTERED CIVIL ENGINEER AND LAND SURVEYOR

I Hereby Certify that this plat shows a survey made by me of the property described on this plat, and that the corners are correctly placed as shown, and that all locations have been correctly shown.


Surveyed For Housing Authority

Date March 1973

Scale 1"= 30'

By REGISTERED LAND SURVEYOR

Lot 21, Block 10, Terrace Park Add. to the City of St. Paul,
Ramsey County, Minnesota, according to the recorded Plat thereof. Subject
to rights of City of St. Paul on the South 33 feet of Said Lot by Deed Book
195 of Deeds, page 7 taken for Widening of Goodrich Ave.

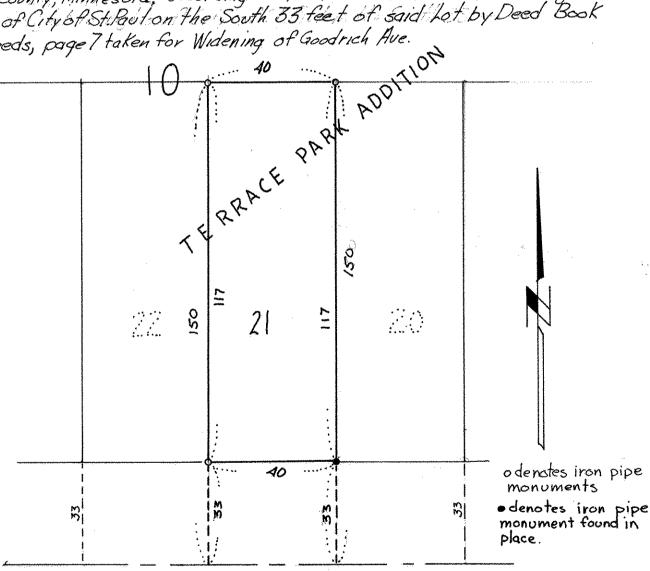

GOODRICH AVE.