NE 6 28 22

FROM THE OFFICE OF

CHARLES O. GEORGI COMPANY

2215 West County Road B — Saint Paul, Minnesota 55113

REGISTERED CIVIL ENGINEER AND LAND SURVEYOR

Certificate of Survey

I Hereby Certify that this plat shows a building location survey made by me on the property described on this plat, and that all locations, have been correctly shown. *There are no encroachments across boundary lines.*

FOR: *Tranamerica, To Whom it may concern, & Kelly, Marshall Associates.*

Date 8th January 1973

Scale 1" = 50'

By *Charles O. Georgi*
REGISTERED LAND SURVEYOR

Description:

Parts of Lots 3 thru 16, Block 11, City of St. Paul
Ramsey County, Minn.

(For complete description refer to attached Survey Dated July 10, 1972)
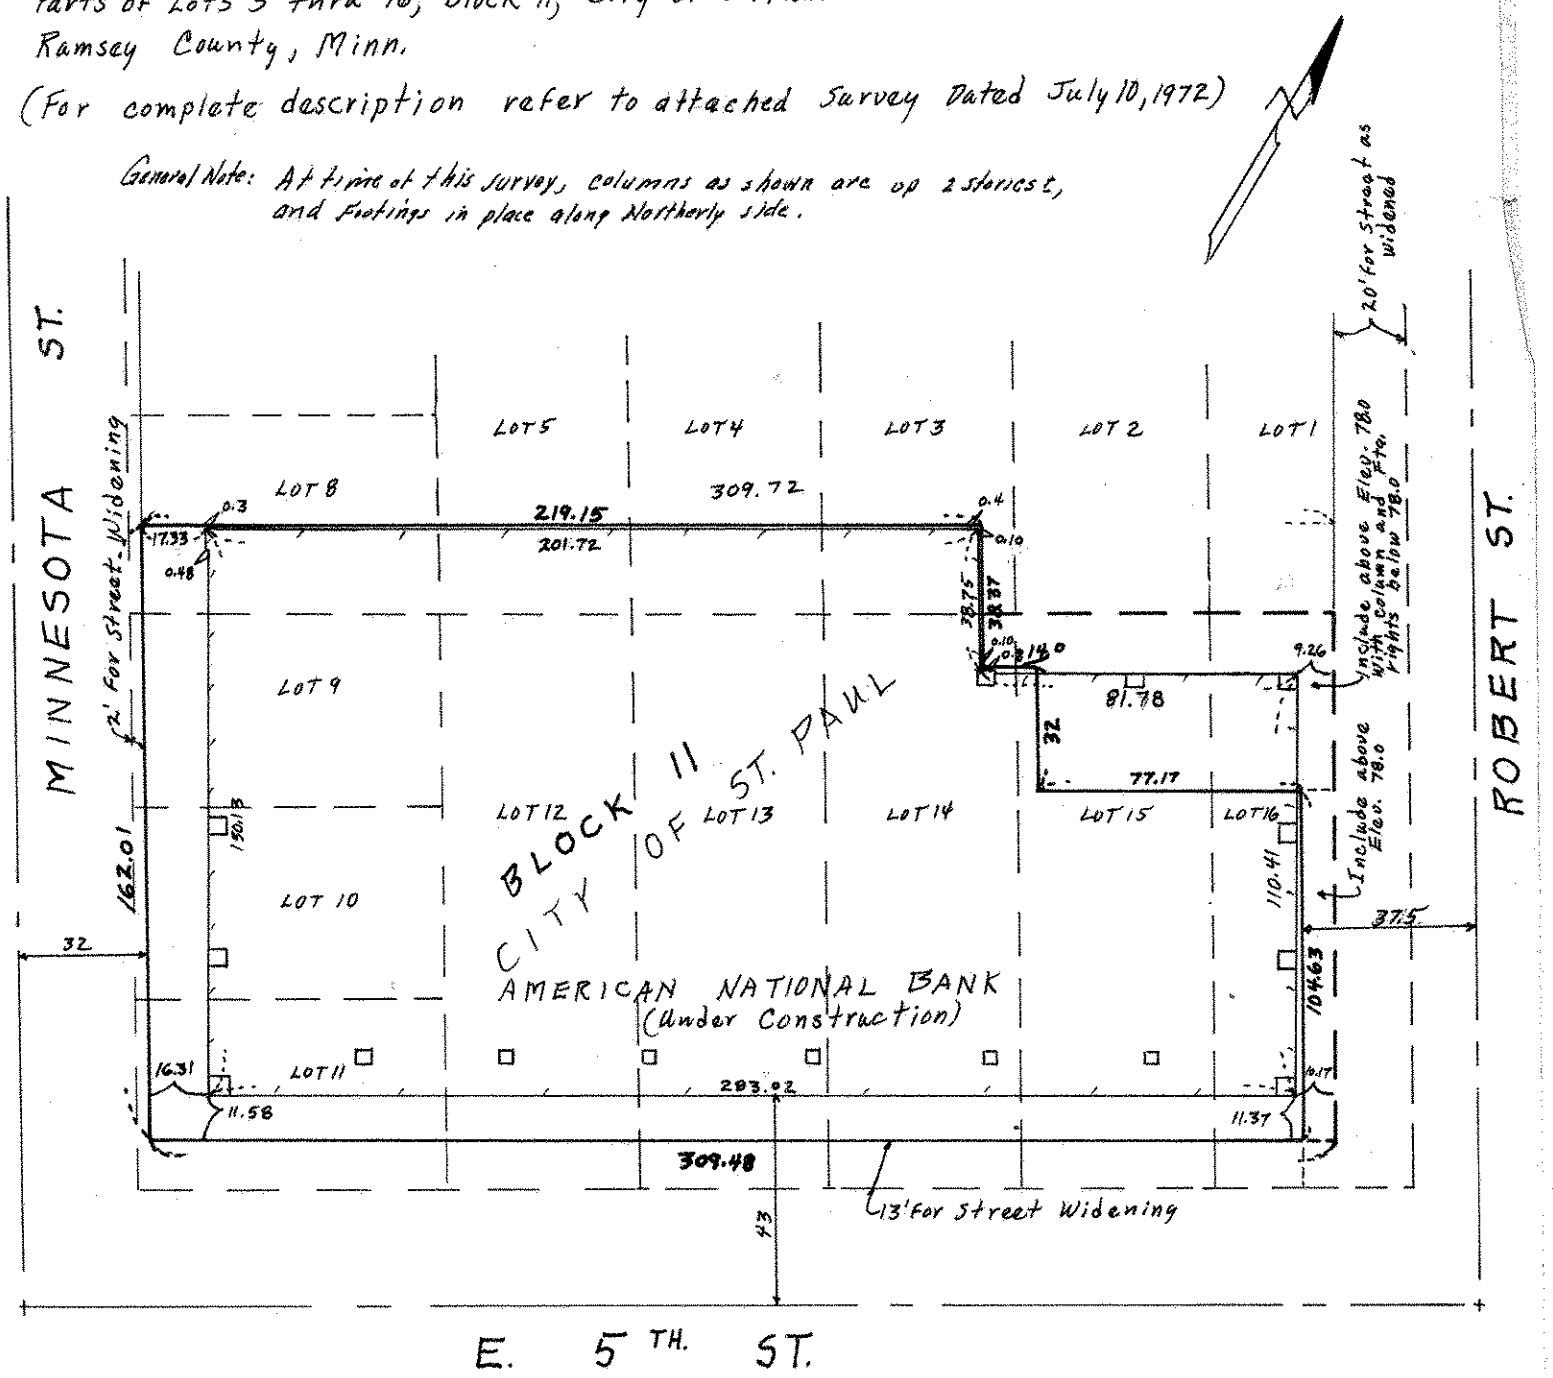
General Note: At time of this survey, columns as shown are up 2 stories±, and footings in place along Northerly side.