Certificate of Survey

FROM THE OFFICE OF

CHARLES O. GEORGI COMPANY

2215 West County Road B — Saint Paul, Minnesota 55113

REGISTERED CIVIL ENGINEER AND LAND SURVEYOR

I Hereby Certify that this plat shows a survey made by me of the property described on this plat, and that the corners are correctly placed as shown, and that all locations have been correctly shown.

Surveyed For Condec Corporation

Date May 2 1973

Scale 1" = 200'

By Charles O. Georgi
REGISTERED LAND SURVEYOR

Description:

The South 458 feet of the East 638.32 feet of the NE¼ of the NW¼ of Section 12, T28N, R22W, Ramsey County, Minn.;
except the South 333 feet of the East 100 feet of the NE¼ of the NW¼ of said Section 12; and
except the North 125 feet of the South 458 feet of the East 330 feet of the NE¼ of the NW¼ of said Section 12;
Subject to Londin Lane.
Contains 5.0 Acres, m.o.l.

Also the East 60 feet of the East 330 feet of that part of the NE¼ of the NW¼ of Section 12, T28N, R22 lying Southerly of the South line of Lower Afton Road except the South 333 feet thereof, Ramsey County, Minn.
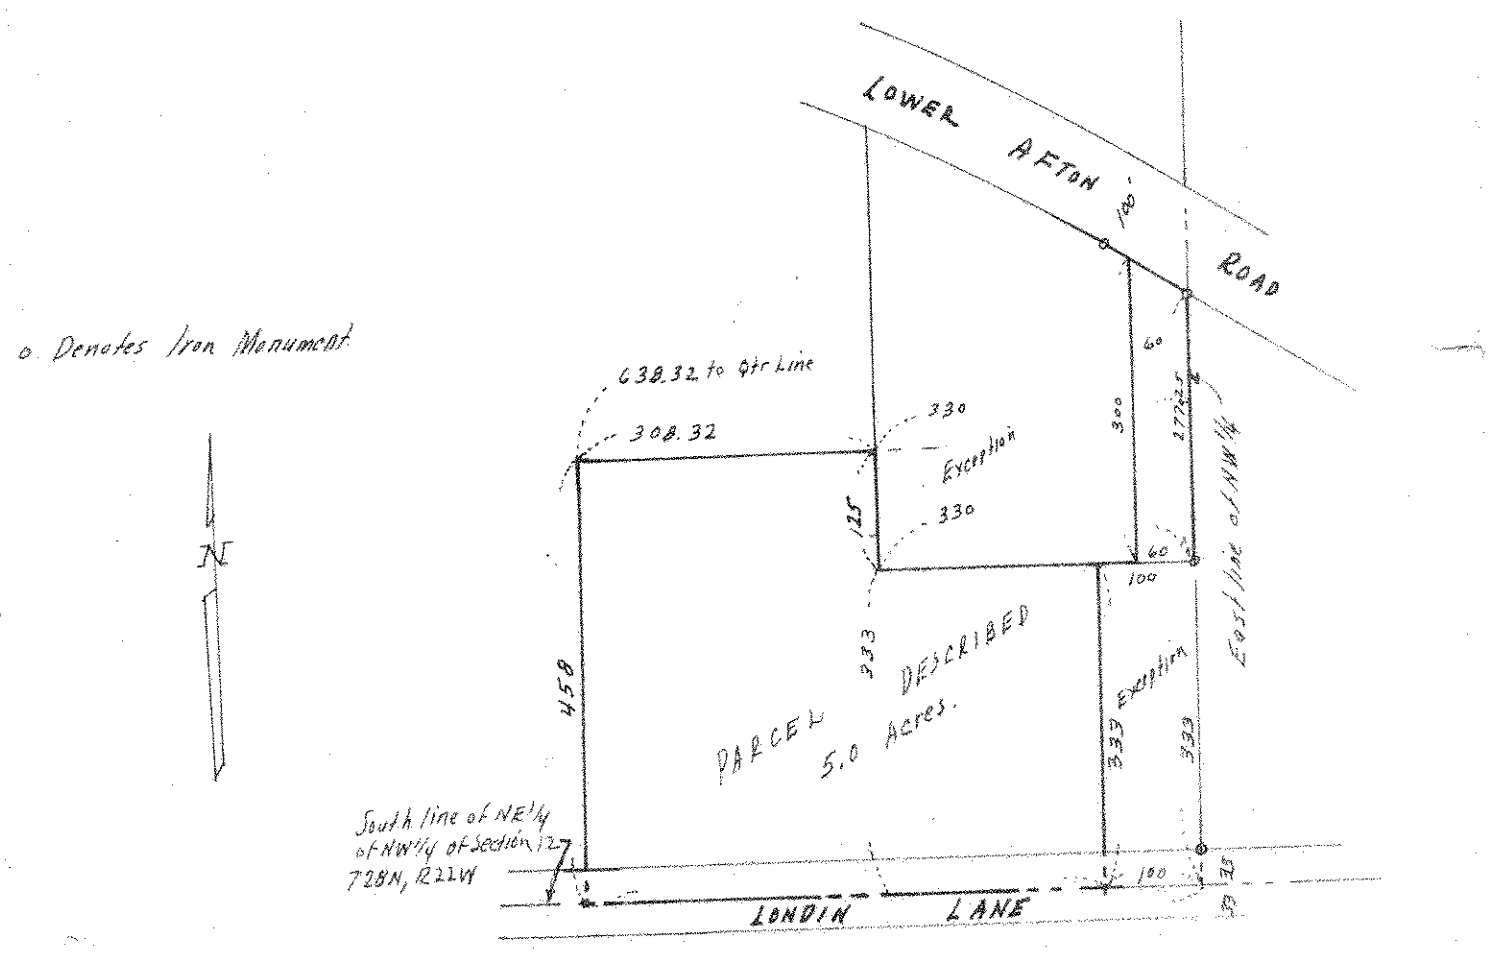
o Denotes Iron Monument