NW 12 28 22

FROM THE OFFICE OF

CHARLES O. GEORGI COMPANY

2215 West County Road B Saint Paul, Minnesota 55113

REGISTERED CIVIL ENGINEER AND LAND SURVEYOR

Certificate of Survey

I Hereby Certify that this plat shows a building location survey made by me on the property described on this plat, and that all locations, have been correctly shown.

Date November 1973

Scale 1" = 100'

By Charles O. Georgi
REGISTERED LAND SURVEYOR

Surveyed For: Condor Corporation

Description:

The South 369.55 feet of the East 622 feet of the NE1/4 of the NW1/4 of Section 12, T28N, R22W, except the North 36.55 feet of the South 369.55 feet of the East 330 feet of the NE1/4 of the NW1/4 of said Section 12.
Subject to Londin Lane, and easements of record.
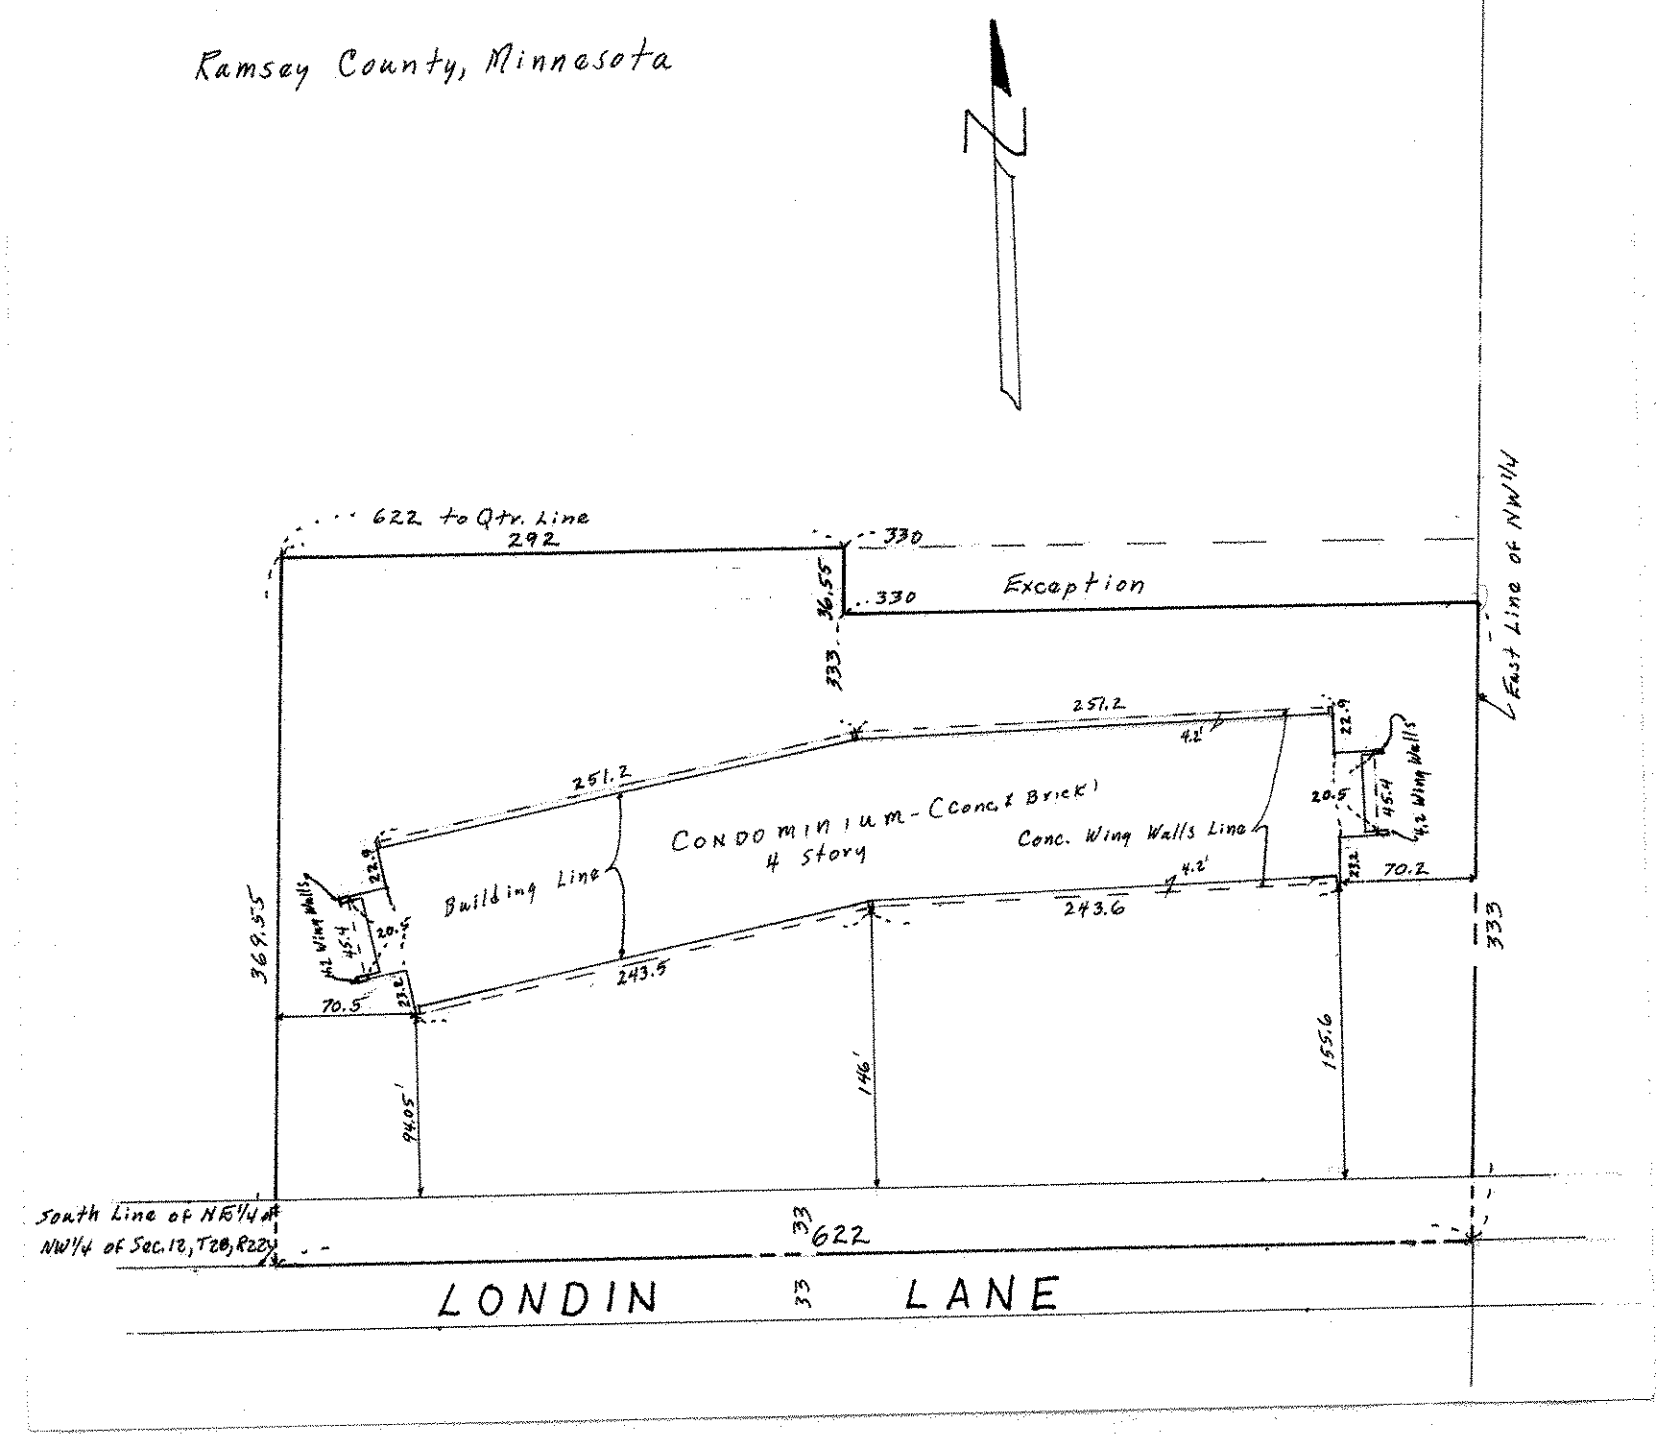
Ramsey County, Minnesota