

Appl. No. S.H. 6874

TELEPHONE 776-0640

## PLAT OF SURVEY


OF PROPERTY OF Choban Realty Co.

DESCRIBED AS FOLLOWS The West 40' of the East 80' of the North 1/2 of Lot 2, Block 50  
Brown and Jackson's Addition  
No. 322 East Sidney Street, St. Paul, Minnesota.

SCALE: 1 INCH = 40 FEET

T. J. WELCH, REGISTERED SURVEYOR  
701 EAST 3RD STREET, ST. PAUL, MINN. 55106

EAST SIDNEY ST.

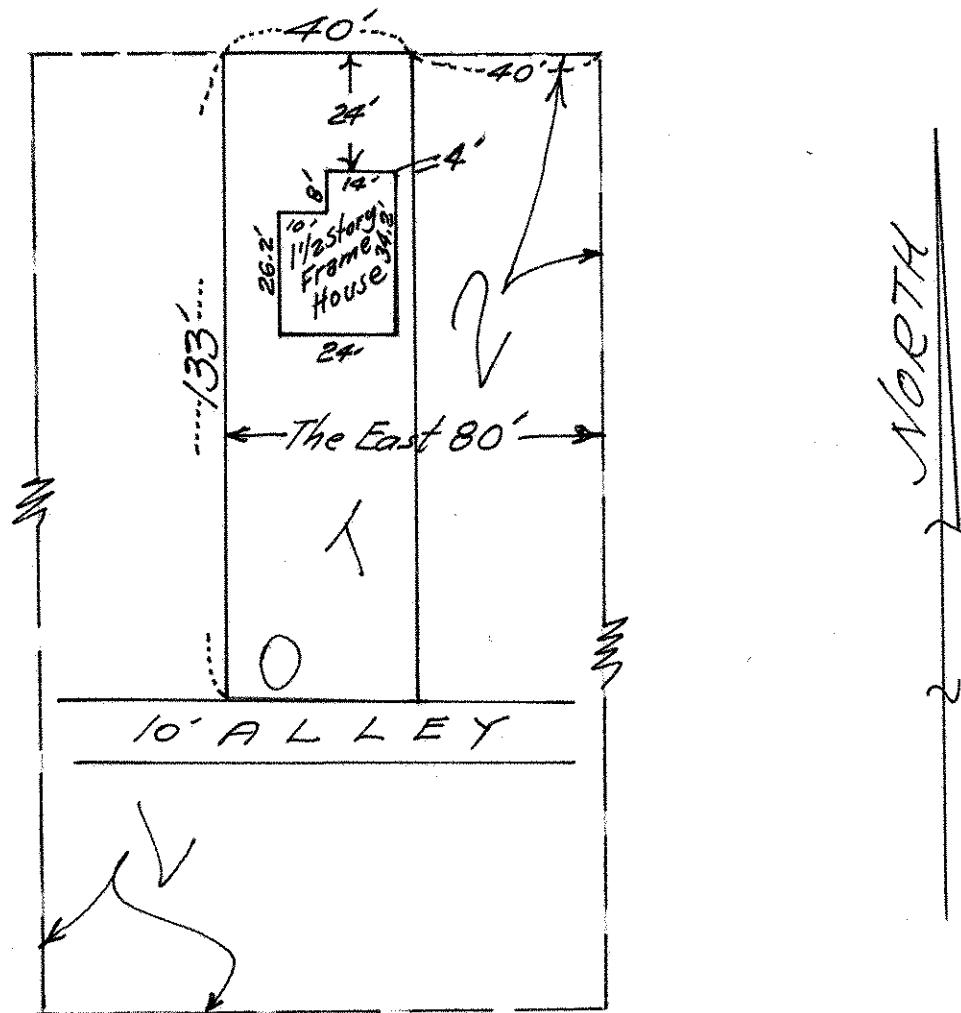

EAST CURTICE ST. CERTIFICATE OF SURVEY

This survey is made exclusively for First Federal Savings and Loan Assn. of St. Paul, Minnesota. Lot lines are not guaranteed as this is survey for mortgage purposes only.

I hereby certify that on March 3, 1973  
I surveyed the property described above and that the above plat is a correct representation of said survey.

T. J. Welch

350/57