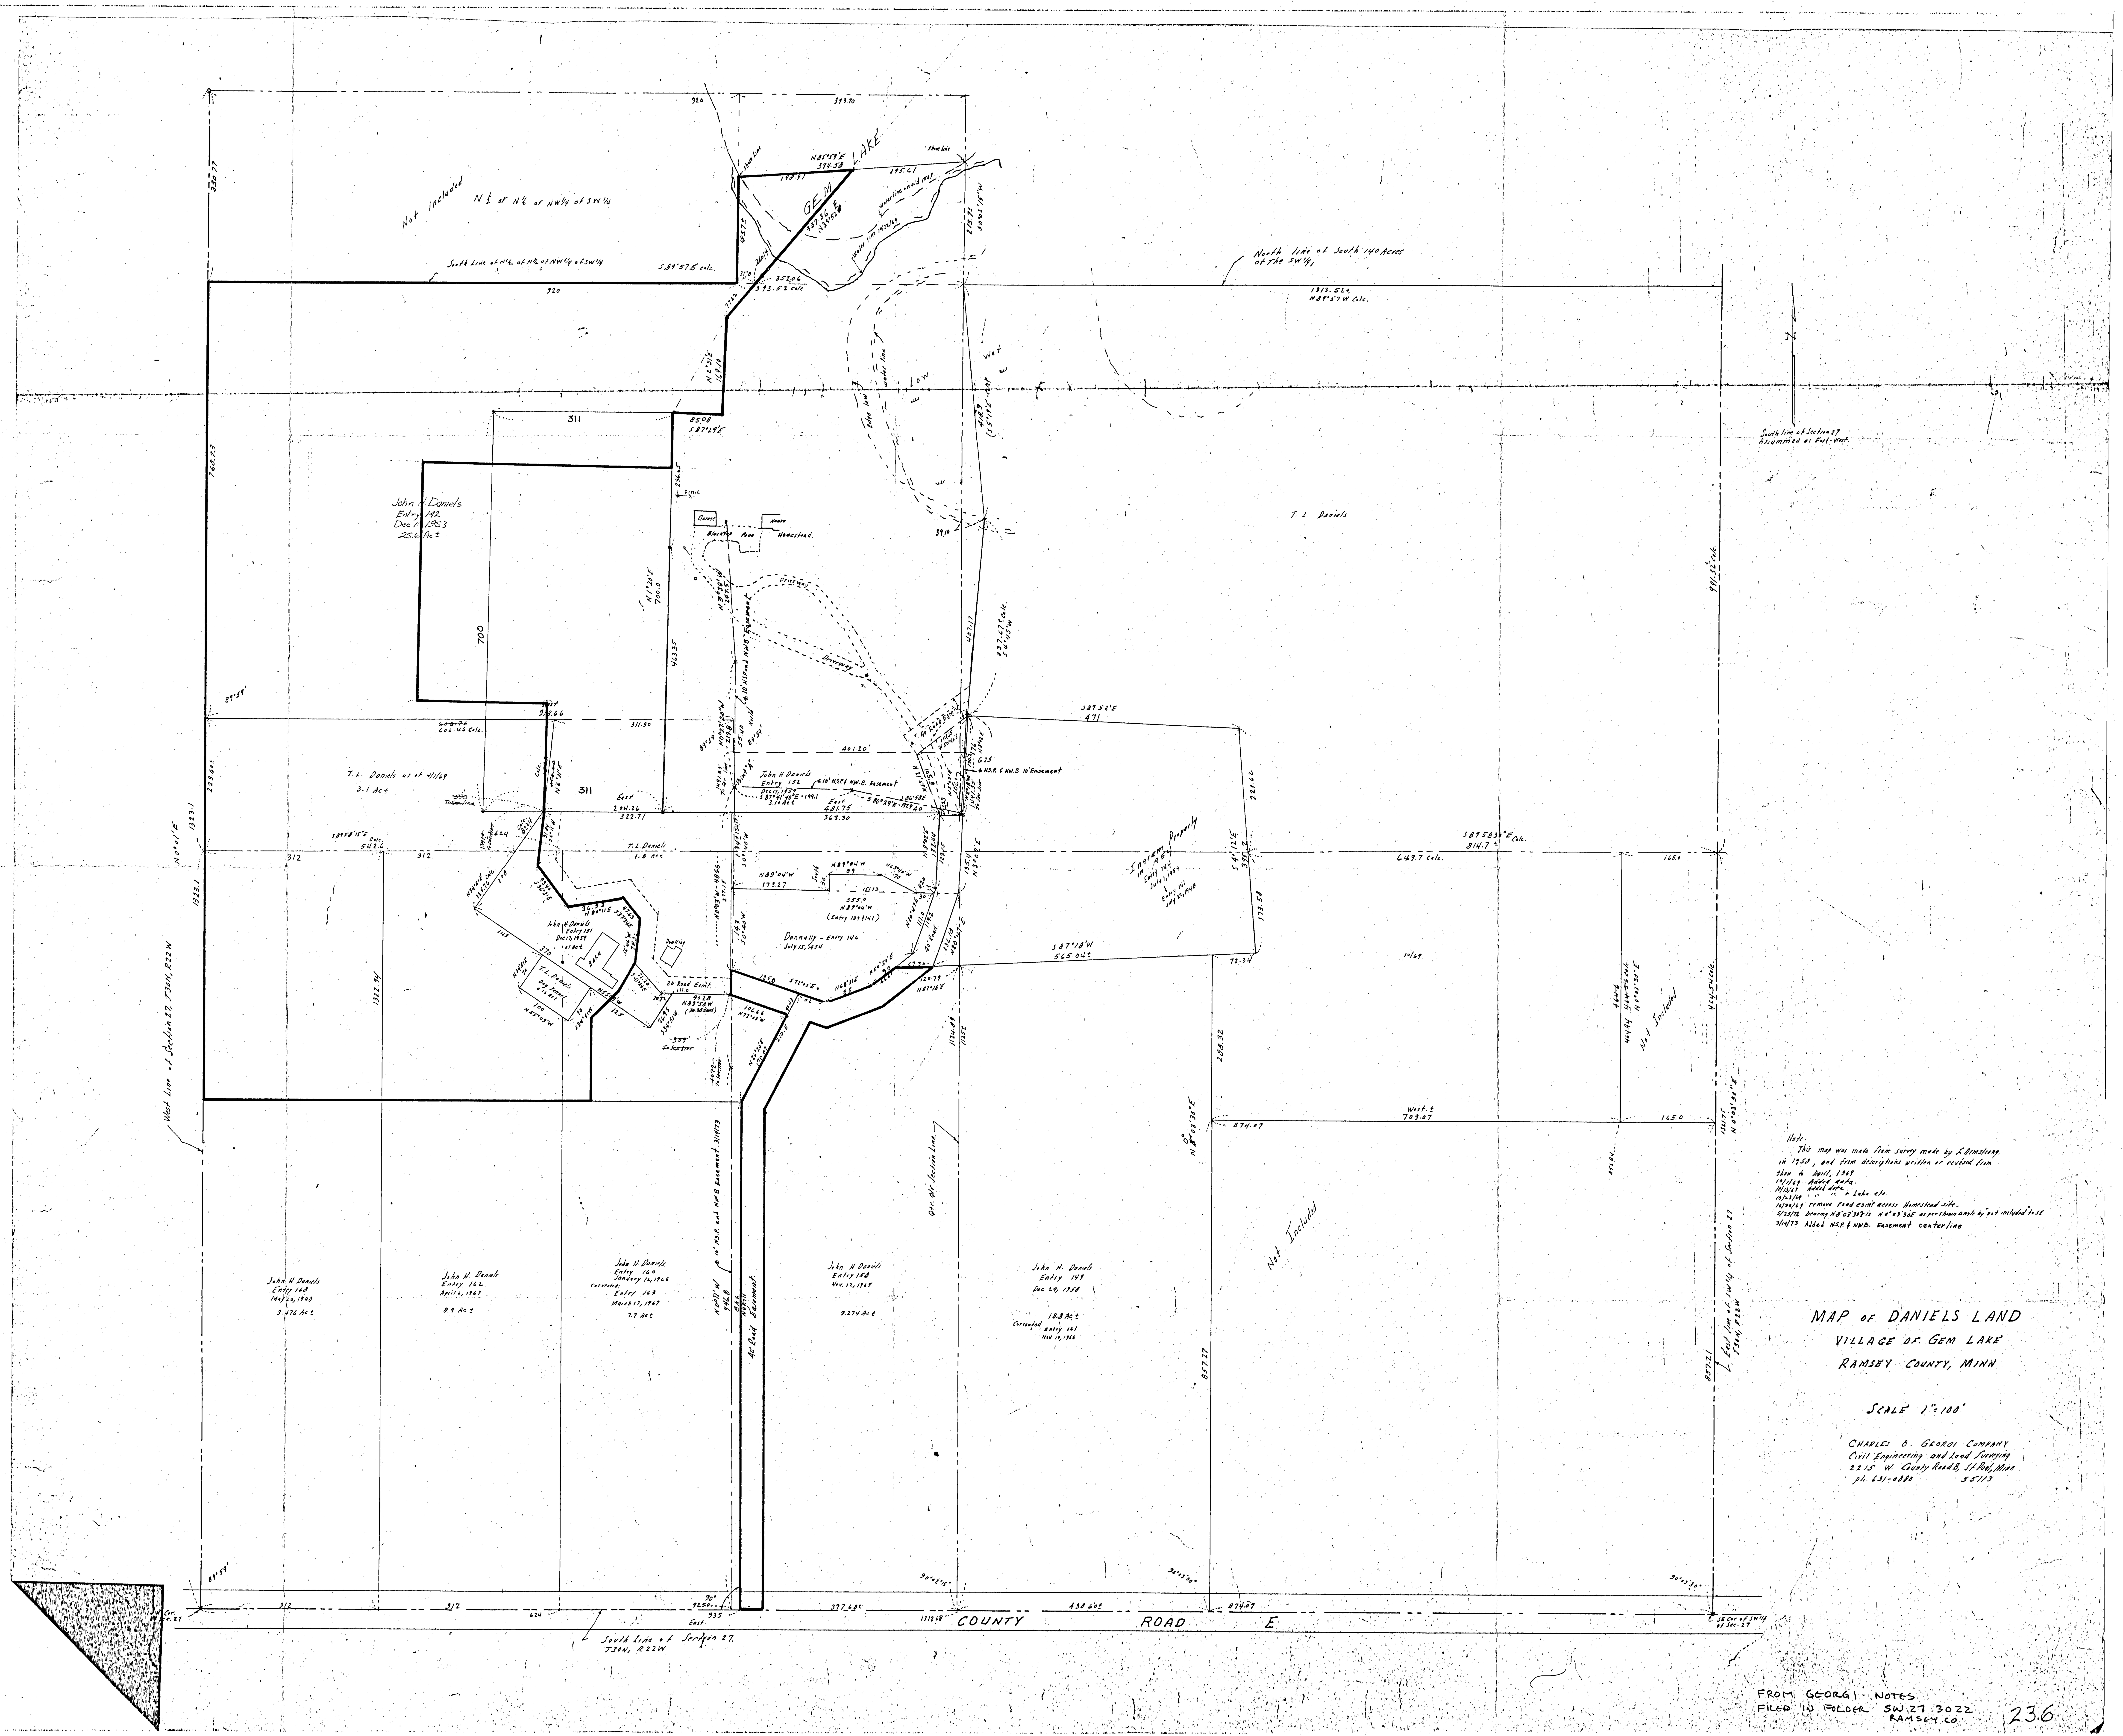
MAP OF DANIELS LAND
VILLAGE OF GEM LAKE
RAMSEY COUNTY, MINN
SCALE 1" = 100'
CHARLES O. GEORGI COMPANY
Civil Engineering and Land Surveying
2215 W. County Road B, St Paul, Minn.
ph. 631-0880 55113
Note:
This map was made from survey made by F. Armstrong in 1958, and from descriptions written or revised from then to April, 1969
10/1/69 Added data.
10/13/69 Added data.
10/23/69 " " " Lake etc.
10/30/69 remove road esmt across Homestead site.
5/25/72 bearing N8°03'30"E is N0°03'30"E as per shown angle by "not included" to SE
3/14/73 Added N.S.P. & NWB. Easement centerline
GEM LAKE
Not Included
N ½ of N ½ of NW ¼ of SW ¼
South Line of N ½ of N ½ of NW ¼ of SW ¼
North line of South 140 Acres of the SW ¼,
South line of Section 27 Assummed as East-West.
John H. Daniels
Entry 142
Dec 10 1953
25.6 Ac ±
T. L. Daniels
T. L. Daniels as of 4/1/69
3.1 Ac ±
T. L. Daniels
1.8 Ac ±
Homestead.
Garage
House
Blacktop Pave
Driveway
John H. Daniels
Entry 152
Dec 17, 1959
3.10 Ac ±
John H. Daniels
Entry 151
Dec 17, 1959
1.0 Ac ±
BARN
T. L. Daniels
Dog kennel
0.16 Ac ±
Dwelling
Donnally - Entry 146
July 15, 1954
Ingram Property
in 1954
Entry 144
July 1, 1954
Entry 141
July 22, 1948
Wet
Low
John H Daniels
Entry 168
May 20, 1968
9.476 Ac ±
John H. Daniels
Entry 162
April 6, 1967
8.9 Ac ±
John H. Daniels
Entry 160
January 12, 1966
Corrected:
Entry 163
March 17, 1967
7.7 Ac ±
John H. Daniels
Entry 158
Nov. 12, 1965
9.274 Ac ±
John H. Daniels
Entry 149
Dec 29, 1958
18.8 Ac ±
Corrected Entry 161
Nov 14, 1966
40' Road Easement
10' N.S.P. and N.W.B. Easement 3/14/73
Qtr. Qtr. Section Line
West Line of Section 27, T30N, R22W
East line of SW ¼ of Section 27 T30N, R22W
South Line of Section 27, T30N, R22W
COUNTY ROAD E
SE Cor of SW ¼ of Sec. 27
Cor. Sec. 27
FROM GEORGI NOTES
FILED IN FOLDER SW 27 3022
RAMSEY CO
236