NE 10 29 23

FROM THE OFFICE OF

CHARLES O. GEORGI COMPANY

2215 West County Road B — Saint Paul, Minnesota 55113

REGISTERED CIVIL ENGINEER AND LAND SURVEYOR

Certificate of Survey

I Hereby Certify that **this plat shows a survey made by me of the property described on this plat, and that the corners are correctly placed as shown, and that all locations have been correctly shown.**

Surveyed For Albert Lokken

Date August 1974

Scale 1" = 60'

By Charles O. Georgi
REGISTERED LAND SURVEYOR

Description:

Except that part taken for County Road "B2" and Subject to Hamline Ave, The West 350 feet of the South 1/8 of the S.W. 1/4 of the N.E 1/4 of Section 10, T29, R23 Ramsey County, Minnesota.

and

The East 213 feet feet of the West 350 feet of the North 1/2 of South 1/4 of the S.W. 1/4 of the N.E. 1/4 of Section 10, T29, R23 Ramsey County, Minnesota.

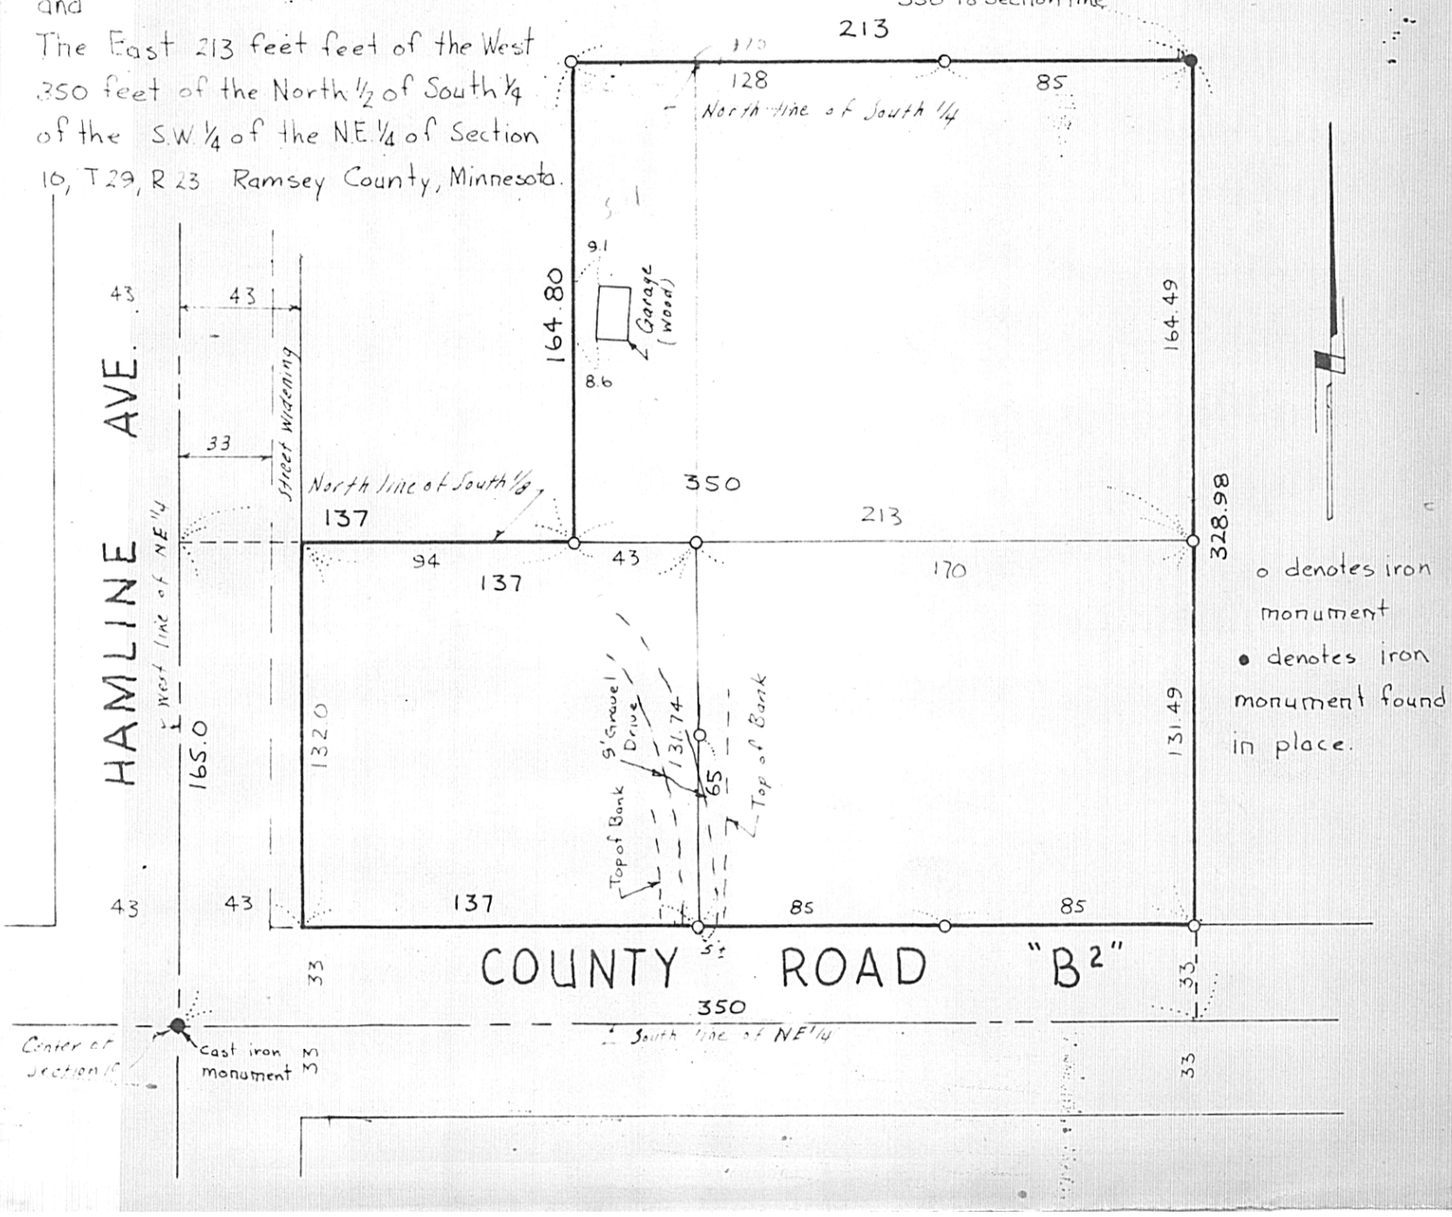

o denotes iron monument

• denotes iron monument found in place.