SW 29 30 22

FROM THE OFFICE OF

CHARLES O. GEORGI COMPANY

2215 West County Road B Saint Paul, Minnesota 55113

REGISTERED CIVIL ENGINEER AND LAND SURVEYOR

Certificate of Survey

I Hereby Certify that **this plat shows a survey made by me of the property described on this plat, and that the corners are correctly placed as shown, and that all locations** and elevations have been correctly shown.

Surveyed For Steve Roberts

Date October 18, 1974

Scale 1" = 40'

By Charles O. Georgi
REGISTERED LAND SURVEYOR
MINNESOTA REGISTRATION #3960

Description:

Lot 6, Block 1, Centre Acres
Ramsey County, Minnesota
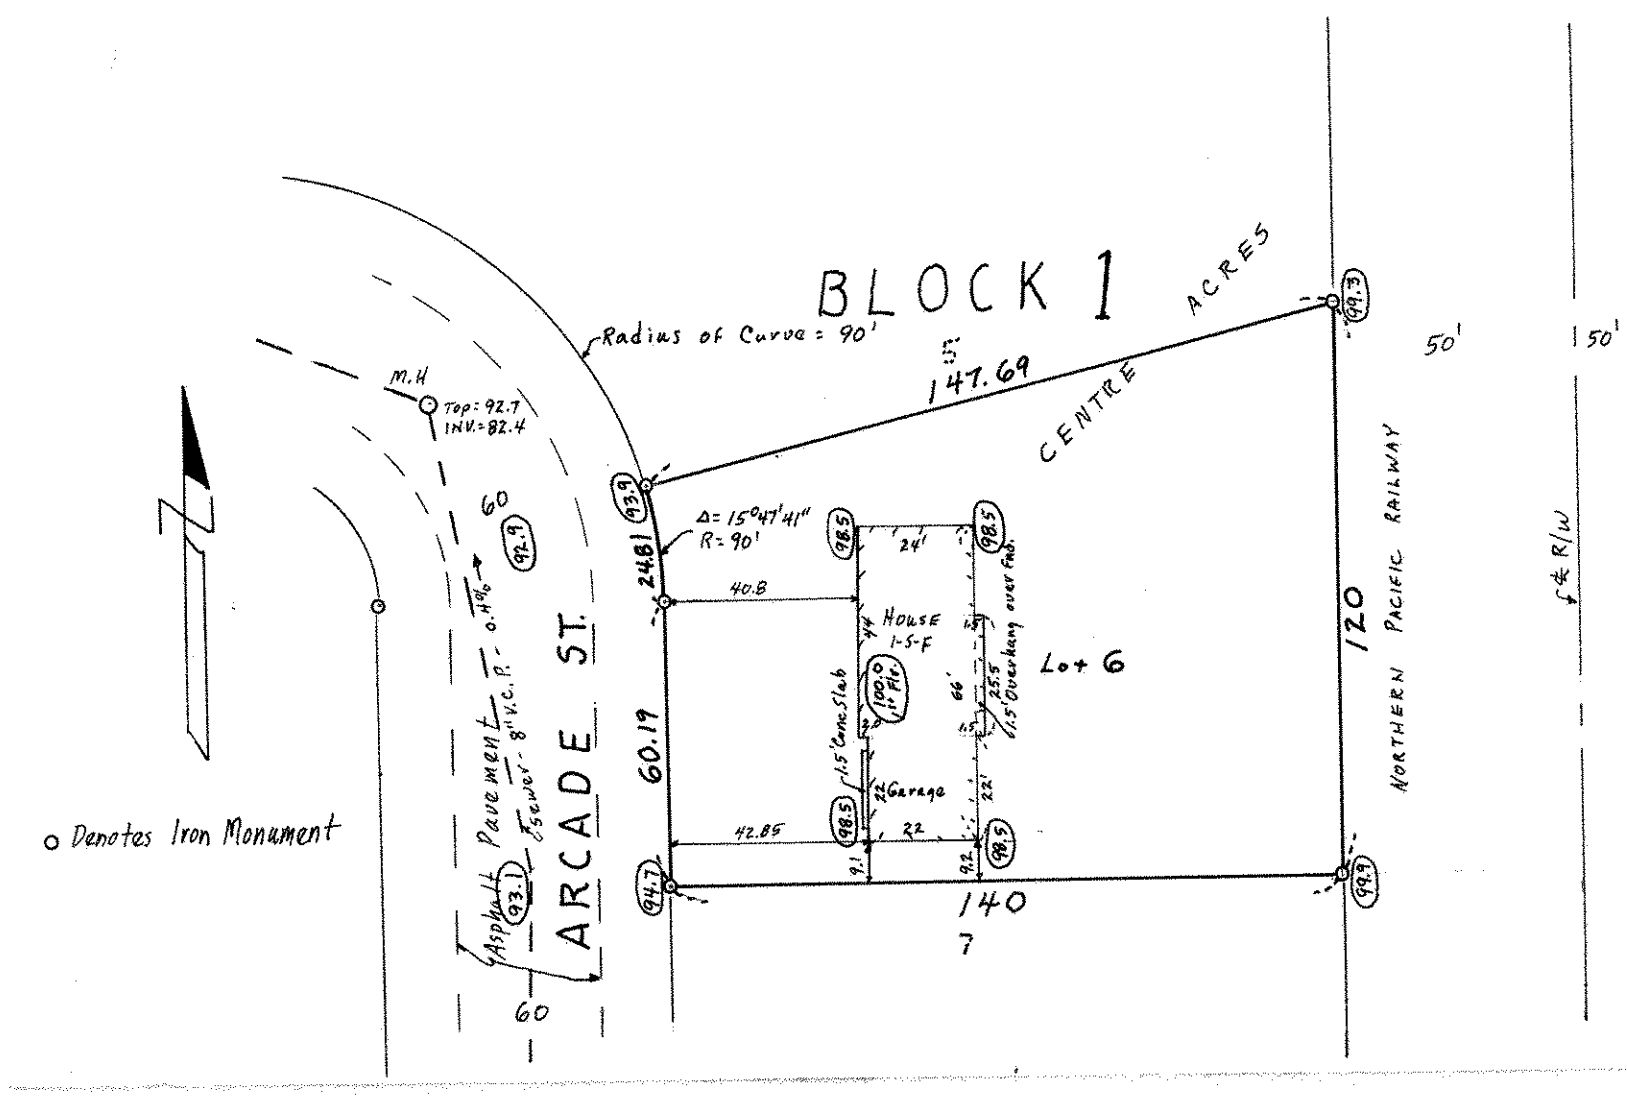
B.M. = 100.0 - 1st Floor of House (Assumed)
(94.7) Denotes Elevations
10/18/74 Under Construction - (No walks or Driveway built)