

FROM THE OFFICE OF

CHARLES O. GEORGI COMPANY

2215 West County Road B

Saint Paul, Minnesota 55113

REGISTERED CIVIL ENGINEER AND LAND SURVEYOR

**Certificate
of Survey**

I Hereby Certify that this plat shows a survey made by me of the property described on this plat, and that the corners are correctly placed as shown, and that all locations have been correctly shown.


Project No. Minn A-1-1
Parcel No. 114-J
Area. 6,310 sq. ft. m.o.l.

Surveyed For Housing Authority
Date May 1974
Scale 1"=40'

By Charles O. Georgi
REGISTERED LAND SURVEYOR

Description:

Lot 24,
Block 1,
Rogers' Addition to St. Paul,
Ramsey County,
Minnesota.

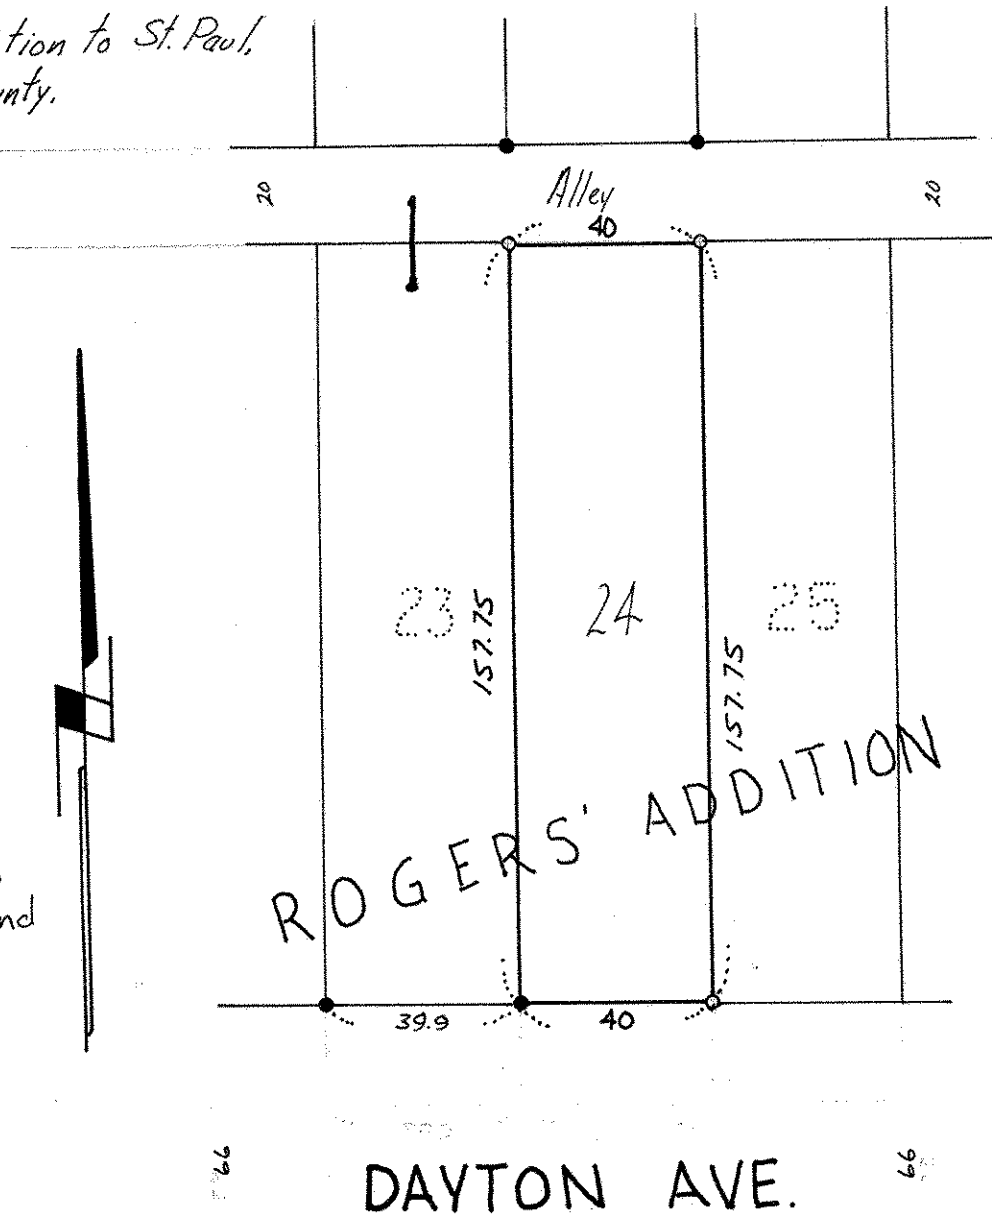

o denotes iron monument

o denotes iron monument found in place.

DAYTON AVE.