



To Don Epstein
From Frank Kwidera

2-15-74
3:15 PM

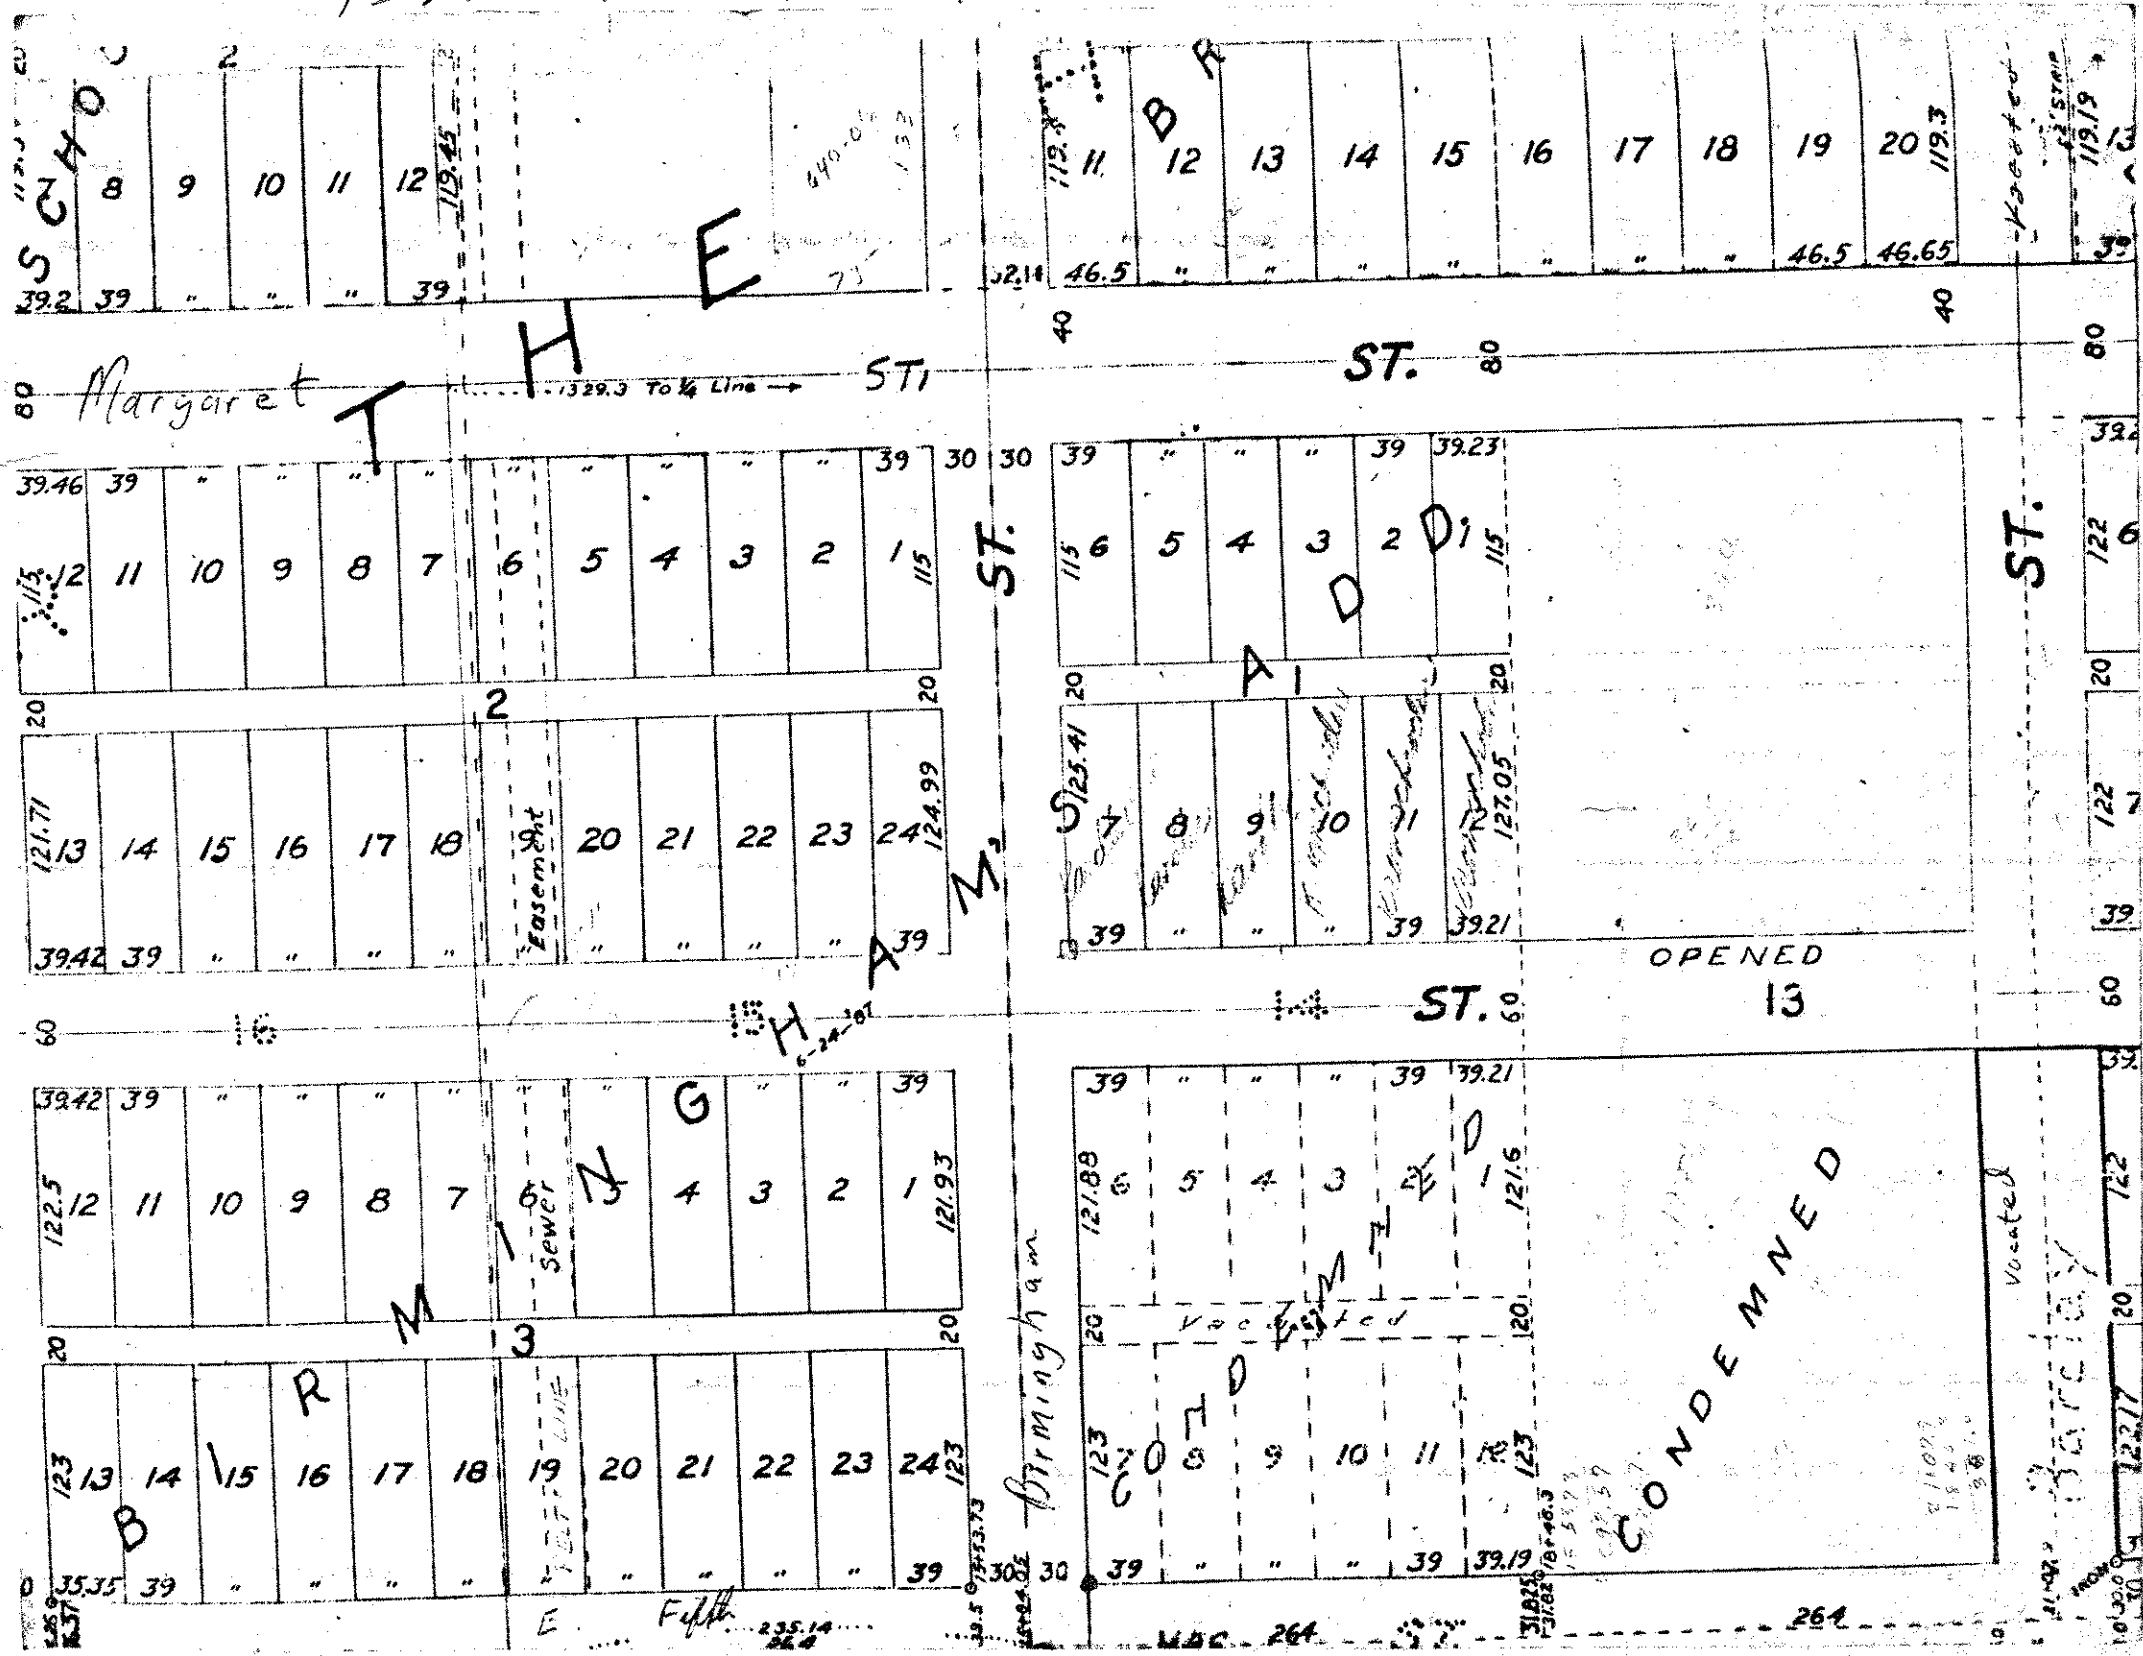

FK
DS
LPC

Feb. 13, 1974

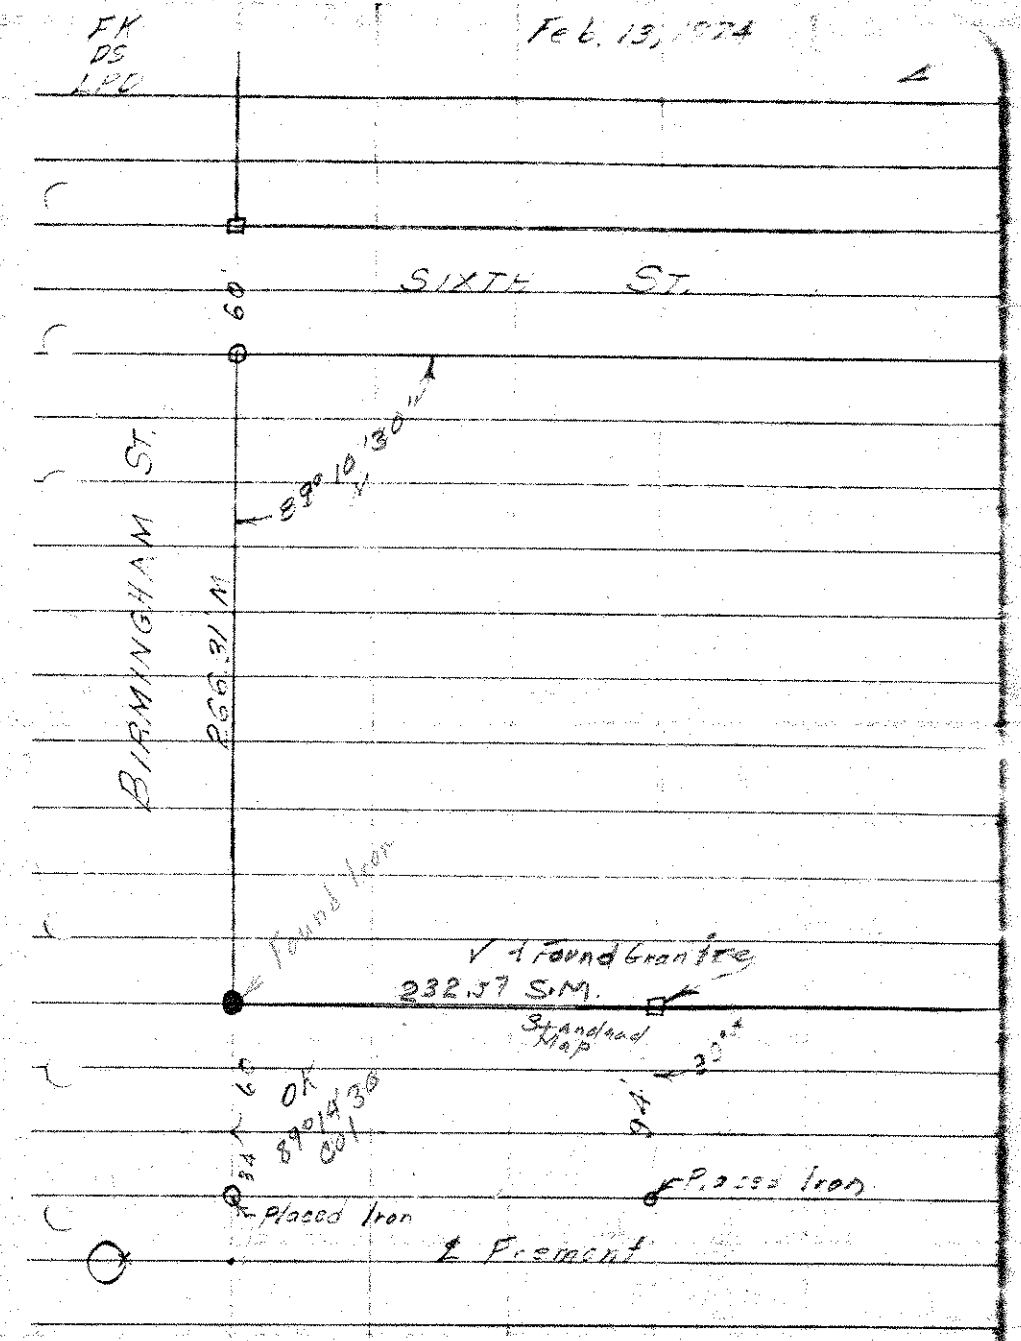

Note

See arena area
Harding H. School
Irons and Monument may
get torn out