SW 2 29 23

# Certificate of Survey

FROM THE OFFICE OF

## CHARLES O. GEORGI COMPANY

2215 West County Road B — Saint Paul, Minnesota 55113

REGISTERED CIVIL ENGINEER AND LAND SURVEYOR

***I Hereby Certify that*** **this plat shows a survey made by me of the property described on this plat, and that the corners are correctly placed as shown, and that all locations have been correctly shown.** 12/9/75 Added Houses, garage and moved rear parcel line.

***Surveyed For*** Harlan Nelson

***Date*** December 1975

***Scale*** 1" = 50'

By Charles O. Georgi

REGISTERED LAND SURVEYOR

***Description:***

That part of the NW 1/4 of the SW 1/4 of Section 2, T29, R23, described as follows: Beginning at a point 752.49 feet South of the Northeast corner of the West 1/2 of the West 1/2 of the SW 1/4 of Section 2, T29, R23; thence South 83.54 feet; thence East 521.49 feet; thence North 83.54 feet to a point 136.3 feet West and 752.49 feet South of the NE corner of the West 1/2 of the SW 1/4 of said Section 2, thence West to the point of beginning Except the East 200 feet thereof and except the West 181.15 feet thereof, Ramsey County, Minnesota

The West 181.15 Feet of that part of the NW 1/4 of the SW 1/4 of Section 2, T29, R23, described as Follows:
Beginning at a point 752.49 Feet South of the Northeast corner of the West 1/2 of the West 1/2 of the SW 1/4 of Section 2, T29, R23, thence South 83.54 Feet; thence East 521.49 Feet; thence North 83.54 Feet to a point 136.3 Feet West and 752.49 South of the NE corner of the West 1/2 of the SW 1/4 of said Section 2, thence West to the point of beginning.

Ramsey County, Minn.
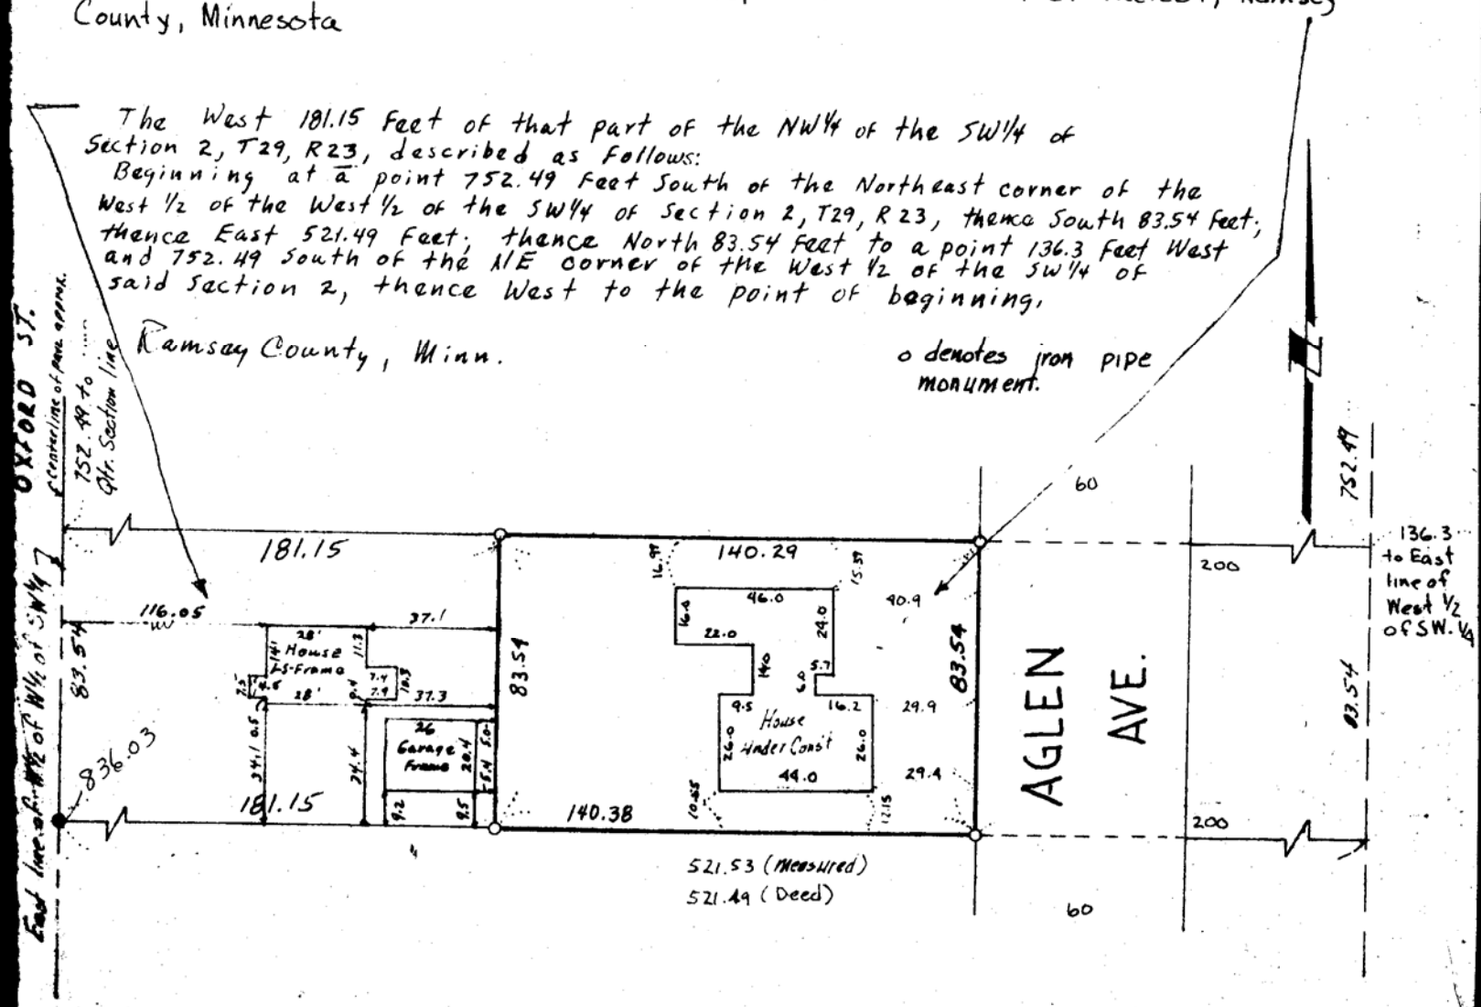
o denotes iron pipe monument.