SW 21 29 2

FROM THE OFFICE OF

CHARLES O. GEORGI COMPANY

2215 West County Road B — Saint Paul, Minnesota 55113

REGISTERED CIVIL ENGINEER AND LAND SURVEYOR

Certificate of Survey

I Hereby Certify that **this plat shows a survey made by me of the property described on this plat, and that the corners are correctly placed as shown, and that all locations have been correctly shown.**

Surveyed For TKDA

Date April 1975

Scale 1" = 500

By Charles O. Georgi

REGISTERED LAND SURVEYOR

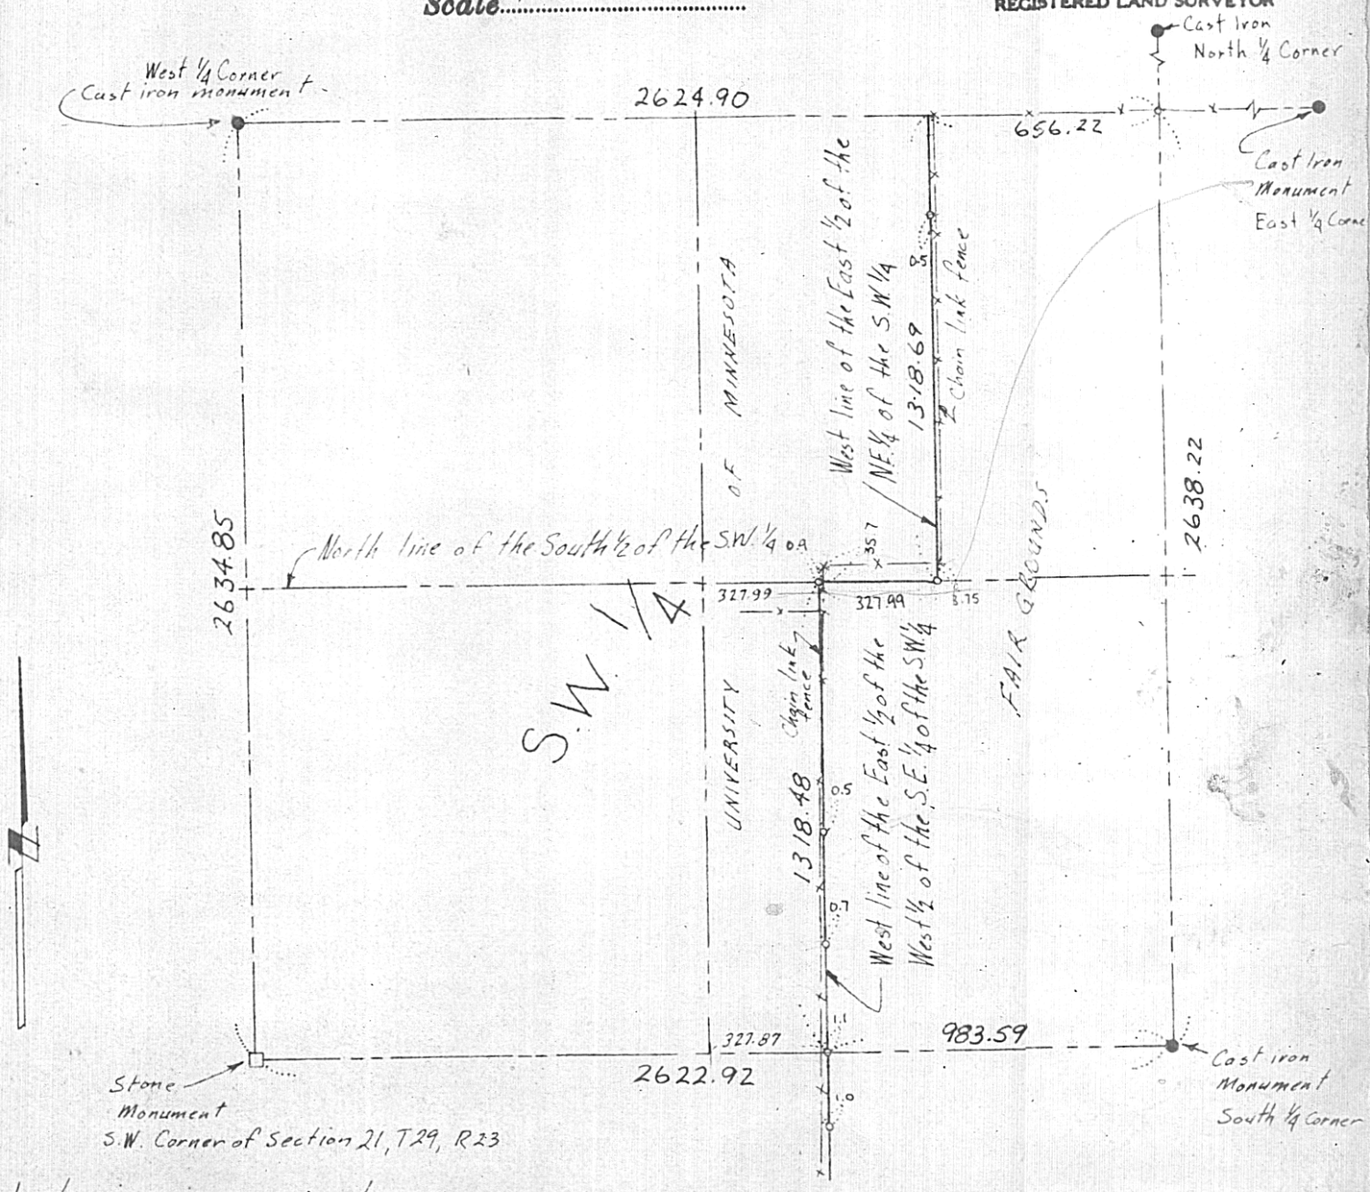

o denotes iron pipe monument