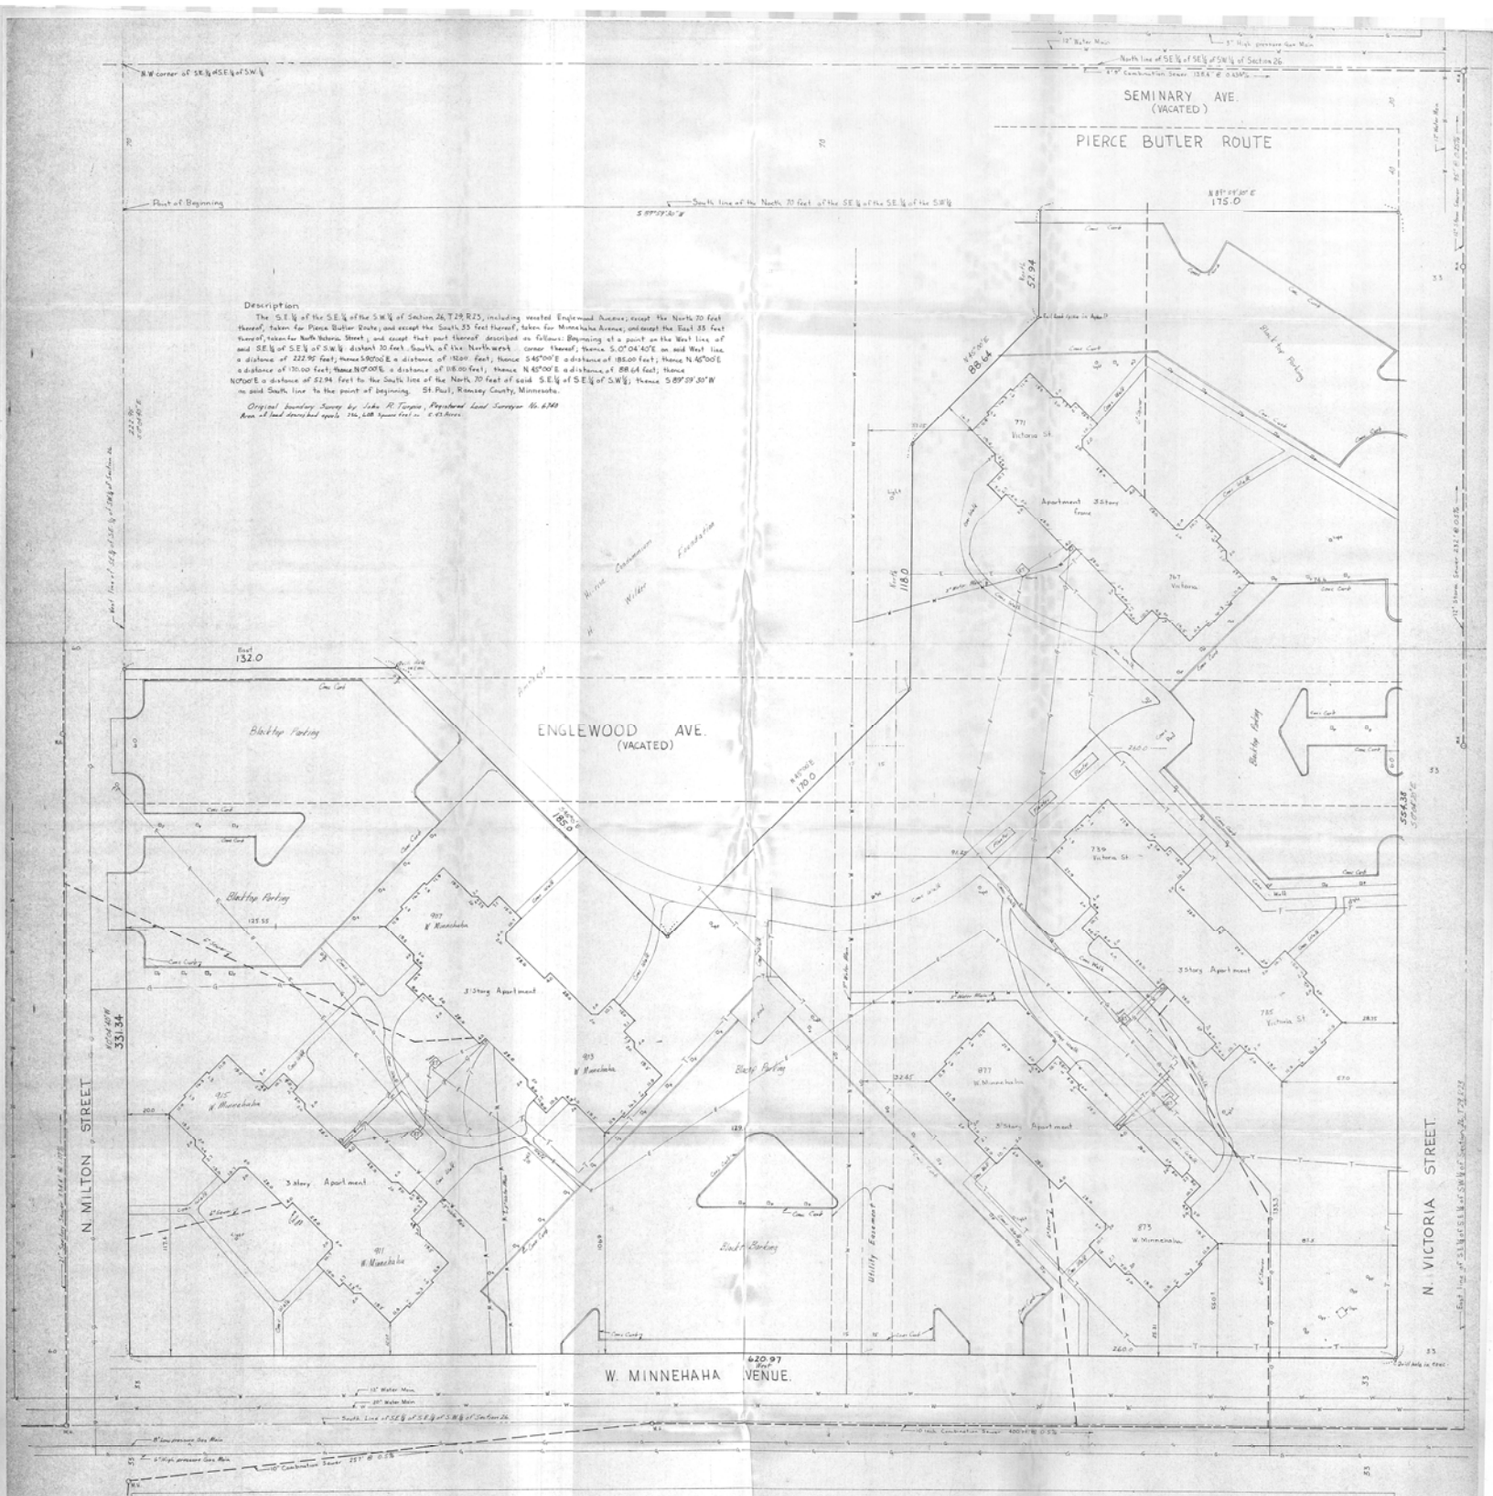

denotes iron monument (except as noted)
denotes Manhole
denotes electrical transformer on R.R. conc. pad
denotes Gas Meter
denotes light pole
denotes Water Main
denotes Gas Main
denotes Sewer
denotes Underground telephone
denotes Underground Electric cable
Boring activities in accordance with as built furnished by Mc Gough Const.

To parties interested in title to premises surveyed I hereby certify that this location map shows a survey made on or under my direct supervision on the day of October 1976
I further certify that this location survey is a correct representation of the premises as determined by said survey
I further certify that there are no visible encroachments either upon or across my boundary line of the premises, other than shown
Signed: this 21st day of October 1976
Charles O. Georgi
Registered Land Surveyor No. 9244
Orig. boundary Survey by John R. Turpin, Registered Surveyor No. 6748

LOCATION MAP
WILDER FOUNDATION HOMES
PROJECT NO 092-44163 NP-R
ST. PAUL MINNESOTA
SCALE 1" = 20'
CHARLES O. GEORGI COMPANY
CIVIL ENGINEERING AND LAND SURVEYING
3092 N. LEXINGTON AVE.
ST. PAUL MINNESOTA 55113
September 1976.

389