SE 25 30 23

Certificate of Survey

FROM THE OFFICE OF

CHARLES O. GEORGI COMPANY

2215 West County Road B Saint Paul, Minnesota 55113

REGISTERED CIVIL ENGINEER AND LAND SURVEYOR

I Hereby Certify that **this plat shows a survey made by me of the property described on this plat, and that the corners are correctly placed as shown, and that all locations have been correctly shown.**

Surveyed For Robert Rieger

Date May 1975

Scale 1" = 60'

By Charles O. Georgi
REGISTERED LAND SURVEYOR

Description:

Lot 12
Block 1
Rowe & Knudson's Wooded Homesites
Ramsey County, Minnesota.
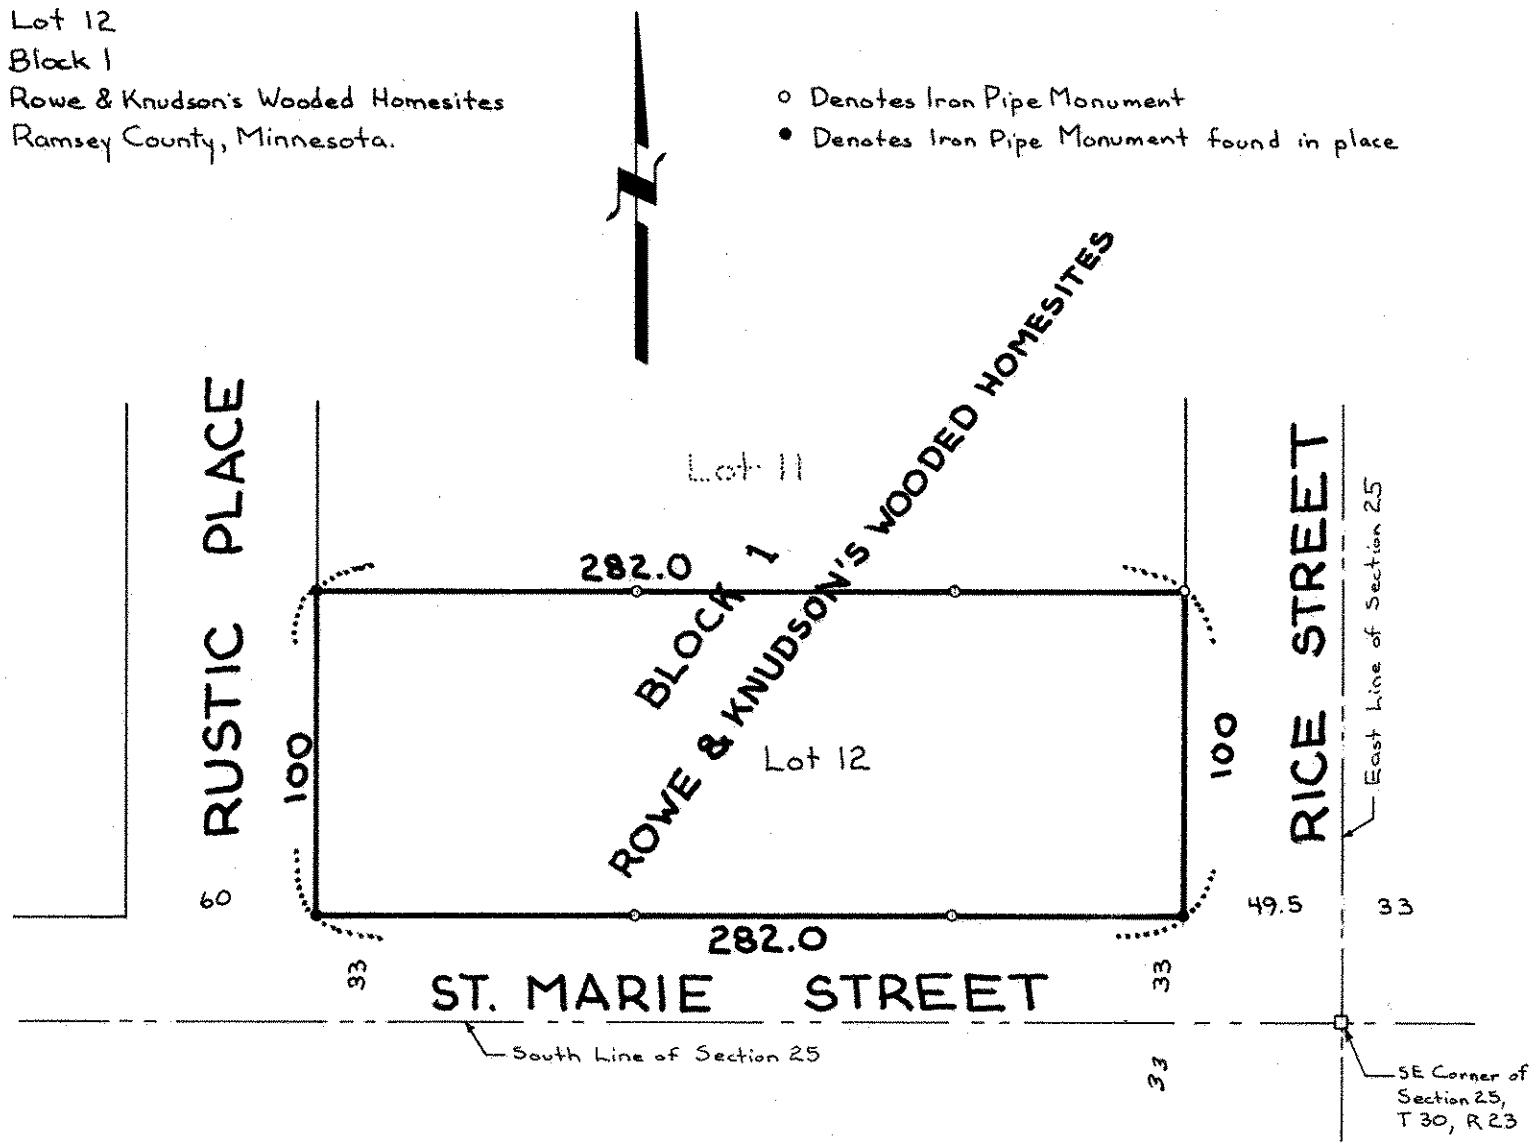
o Denotes Iron Pipe Monument
• Denotes Iron Pipe Monument found in place