SW 29 30 22

FROM THE OFFICE OF

CHARLES O. GEORGI COMPANY

2215 West County Road B Saint Paul, Minnesota 55113

REGISTERED CIVIL ENGINEER AND LAND SURVEYOR

Certificate of Survey

I Hereby Certify that **this plat shows a survey made by me of the property described on this plat, and that the corners are correctly placed as shown, and that all locations have been correctly shown.** and elevations have been Correctly Shown

Surveyed For Steve Roberts

Date June 1975

Scale 1" = 30'

By Charles O. Georgi
REGISTERED LAND SURVEYOR
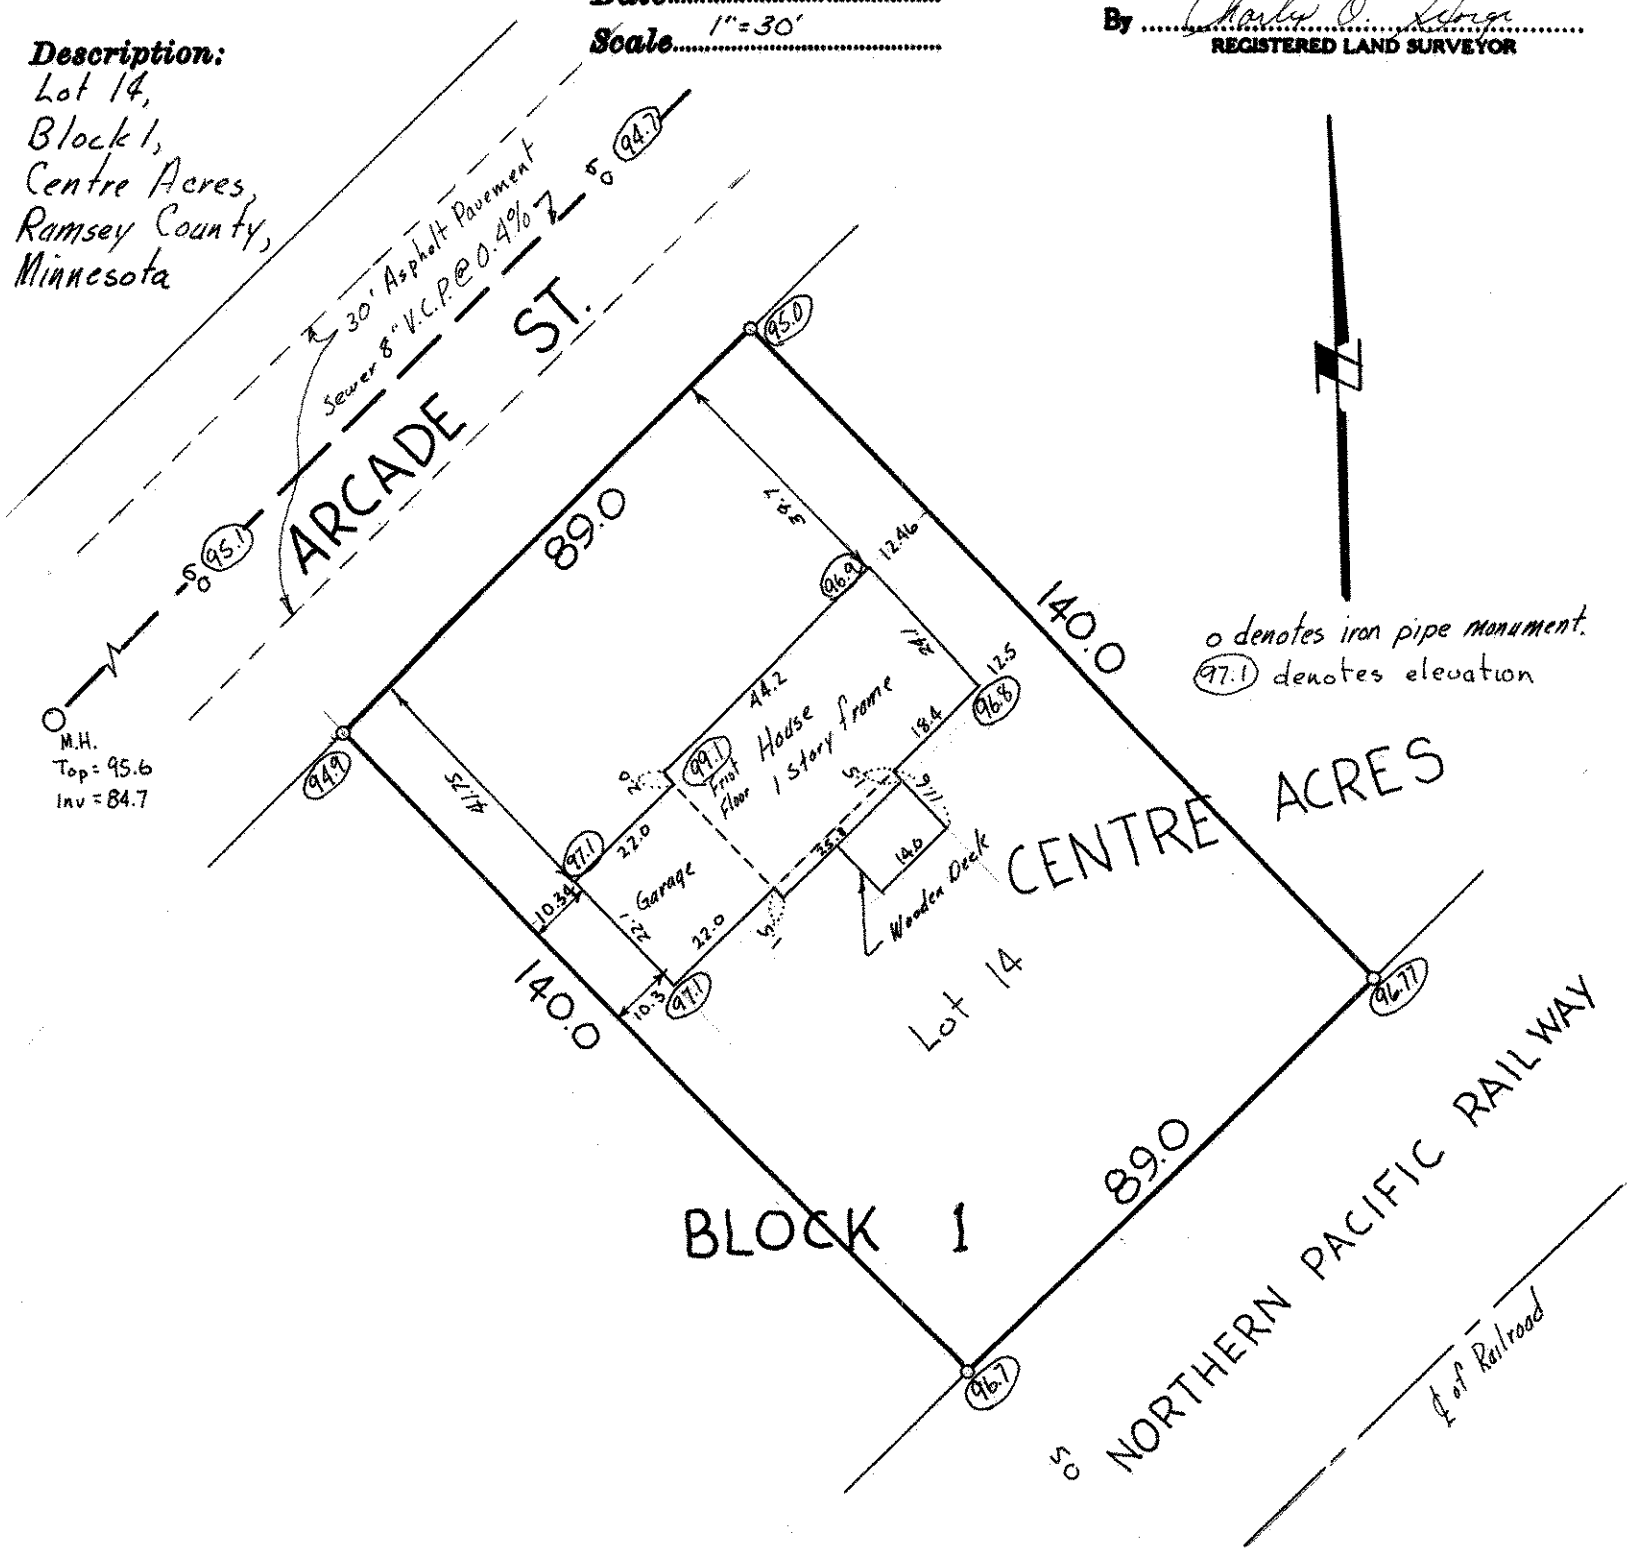
Description:
Lot 14,
Block 1,
Centre Acres,
Ramsey County,
Minnesota