NW 14 30 22

FROM THE OFFICE OF

CHARLES O. GEORGI COMPANY

2215 West County Road B Saint Paul, Minnesota 55113

REGISTERED CIVIL ENGINEER AND LAND SURVEYOR

Certificate of Survey

I Hereby Certify that **this plat shows a survey made by me of the property described on this plat, and that the corners are correctly placed as shown, and that all locations have been correctly shown.**

Surveyed For Art Seebach

Date January 1975

Scale 1" = 60'

By Donald W Schmidt
REGISTERED LAND SURVEYOR

Description:

Lot 12 except the West 225 feet,
Oakhurst Acres,
Ramsey County, Minnesota

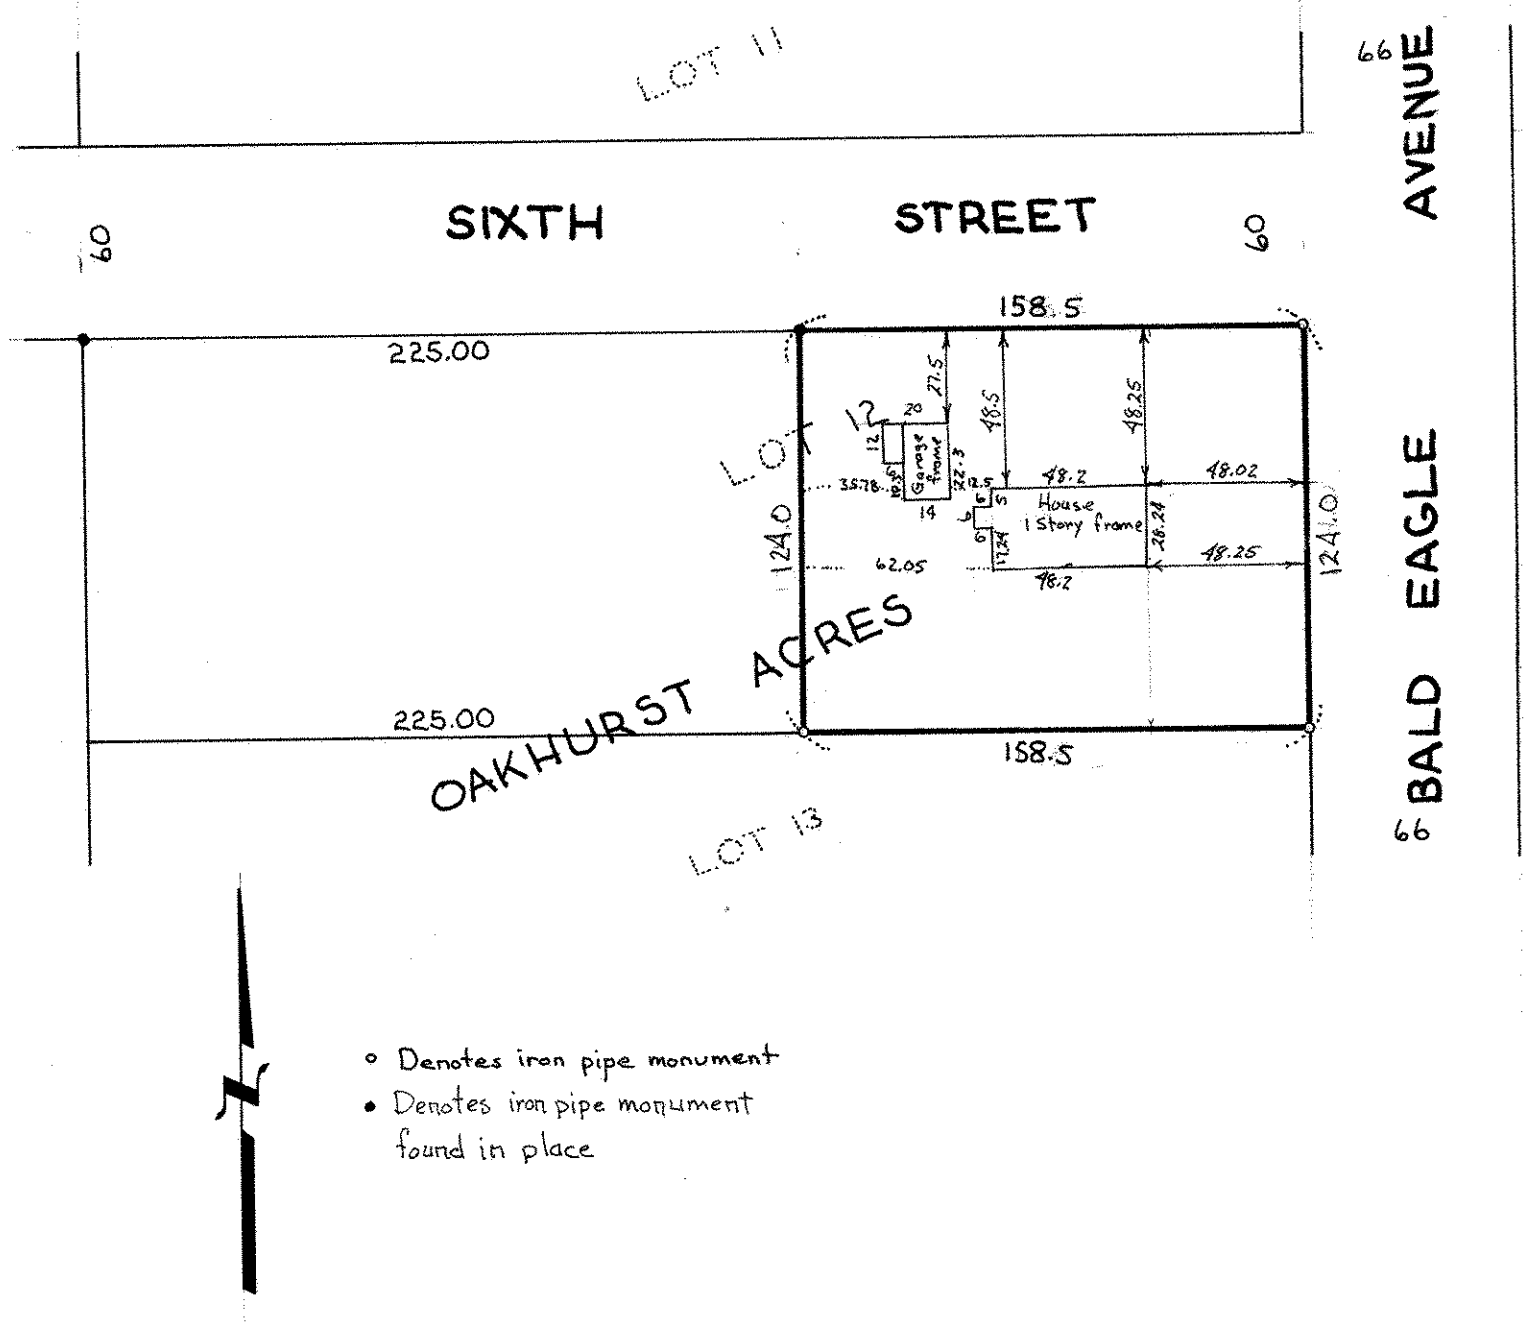

- ○ Denotes iron pipe monument
- • Denotes iron pipe monument found in place