18th 4th AVE. S.E.
ST. CLOUD, MN 56301
612 251-7751

MILNER & CARLEY & ASSOCIATES
Consulting Engineers — Land Surveyors

314 OAK ST.
SAUK CENTRE, MN 56378
612-352-3664

500 W. HWY. 96, ST. PAUL, MN 55112 612-484-3301

I hereby certify that this Certificate of Survey ■ Description ☐ Easement ☐ Plan ☐ Specification ☐ or Building Location ☐ was prepared by me or under my direct supervision and that I am a duly Registered Land Surveyor ■ under the laws of the State of Minnesota.

_____ Reg. No. 3527 Date 10-13-75

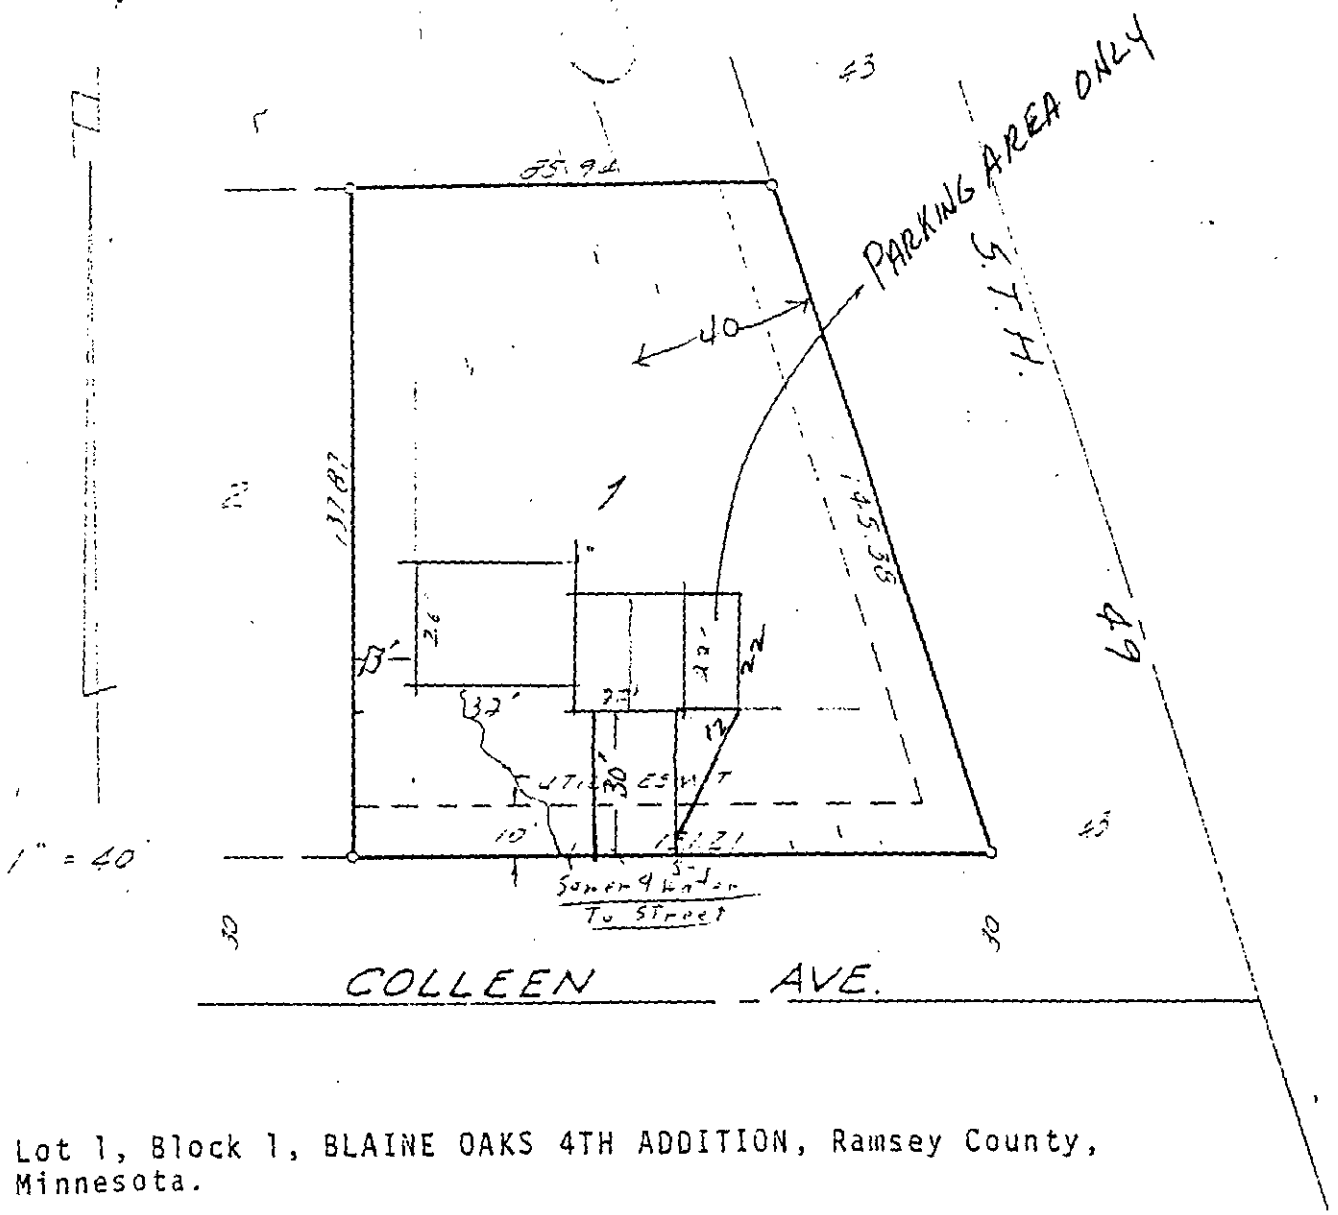

Lot 1, Block 1, BLAINE OAKS 4TH ADDITION, Ramsey County, Minnesota.