


18th 4th AVE, S.E.
ST. CLOUD, MN 56301
612-251-7751

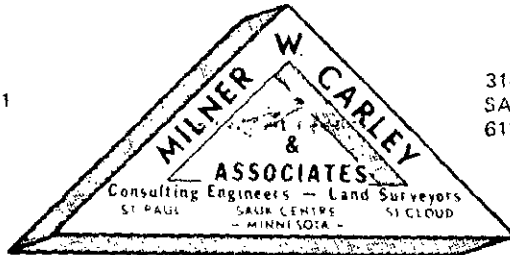

314 OAK ST.
SAUK CENTRE, MN 56378
612-352-3664


500 W. HWY. 96, ST. PAUL, MN 55112 612-484-3301

I hereby certify that this Certificate of Survey Description Easement Plan Specification or Building Location was prepared by me or under my direct supervision and that I am a duly Registered Land Surveyor under the laws of the State of Minnesota.

Milner W. Carley

Reg. No. 3527 Date 10-13-75

COLLEEN AVE.

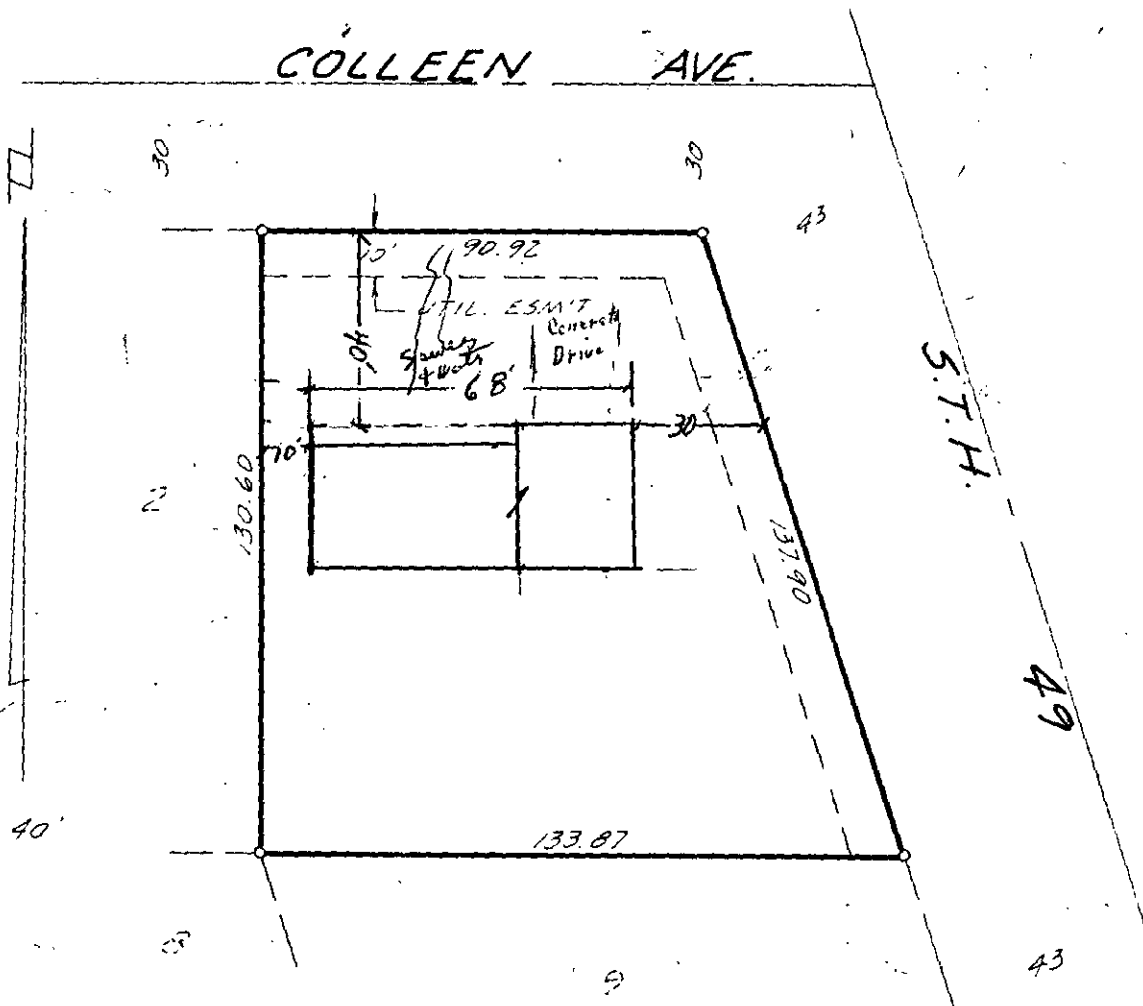

Lot 1, Block 2, BLAINE OAKS 4TH ADDITION, Ramsey County, Minnesota.

316 - Colleen

OWNER:
Daniel Parent

75-327