SW 1 28 23

FROM THE OFFICE OF

CHARLES O. GEORGI COMPANY

2215 West County Road B Saint Paul, Minnesota 55113

REGISTERED CIVIL ENGINEER AND LAND SURVEYOR

Certificate of Survey

Project No. Minn A-1-7
Parcel No. 59 M
Area 4244 sq.ft. m.o.l.

I Hereby Certify that **this plat shows a survey made by me of the property described on this plat, and that the corners are correctly placed as shown, and that all locations have been correctly shown.**

Surveyed For Housing Authority

Date Feb 1975

Scale 1" = 40'

By Charles O. Georgi
REGISTERED LAND SURVEYOR

Description:

The East 1/3 of Lot 1 and the East 1/3 of the South 1/2 of Lot 2 except the North 3 feet, Block 3, Wille's Addition to St. Paul, Ramsey County, Minnesota

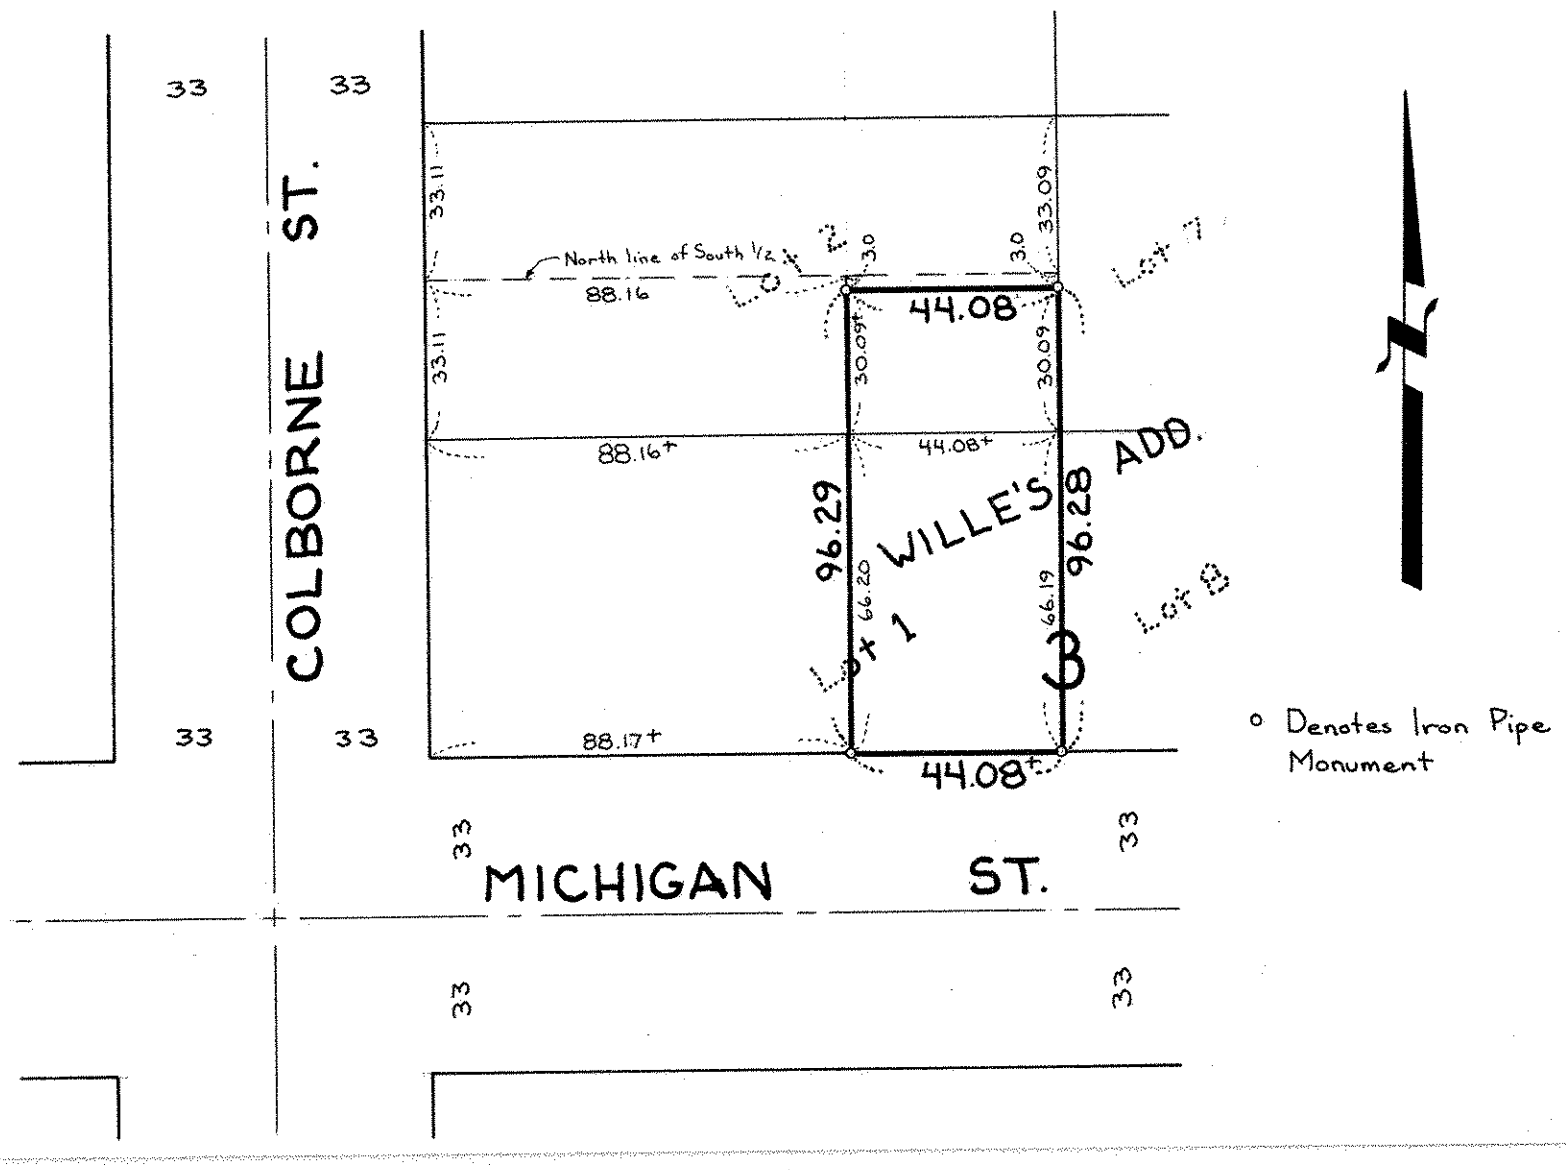

o Denotes Iron Pipe Monument