SE 7 28 22

FROM THE OFFICE OF

CHARLES O. GEORGI COMPANY

2215 West County Road B Saint Paul, Minnesota 55113

REGISTERED CIVIL ENGINEER AND LAND SURVEYOR

Certificate of Survey

I Hereby Certify that **this plat shows a survey made by me of the property described on this plat, and that the corners are correctly placed as shown, and that all locations have been correctly shown.**

Surveyed For DONALD J. HOLMAN

Date AUGUST 1975

Scale 1" = 50'

By Charles O. Georgi
REGISTERED LAND SURVEYOR

Description:

THE WEST 1/3 OF LOTS 1, 2 AND 3, AND
THE EAST 1/3 OF LOTS 4, 5 AND 6, BLOCK C,
JACKSON AND BIDWELL'S ADDITION.
RAMSEY COUNTY, MINNESOTA

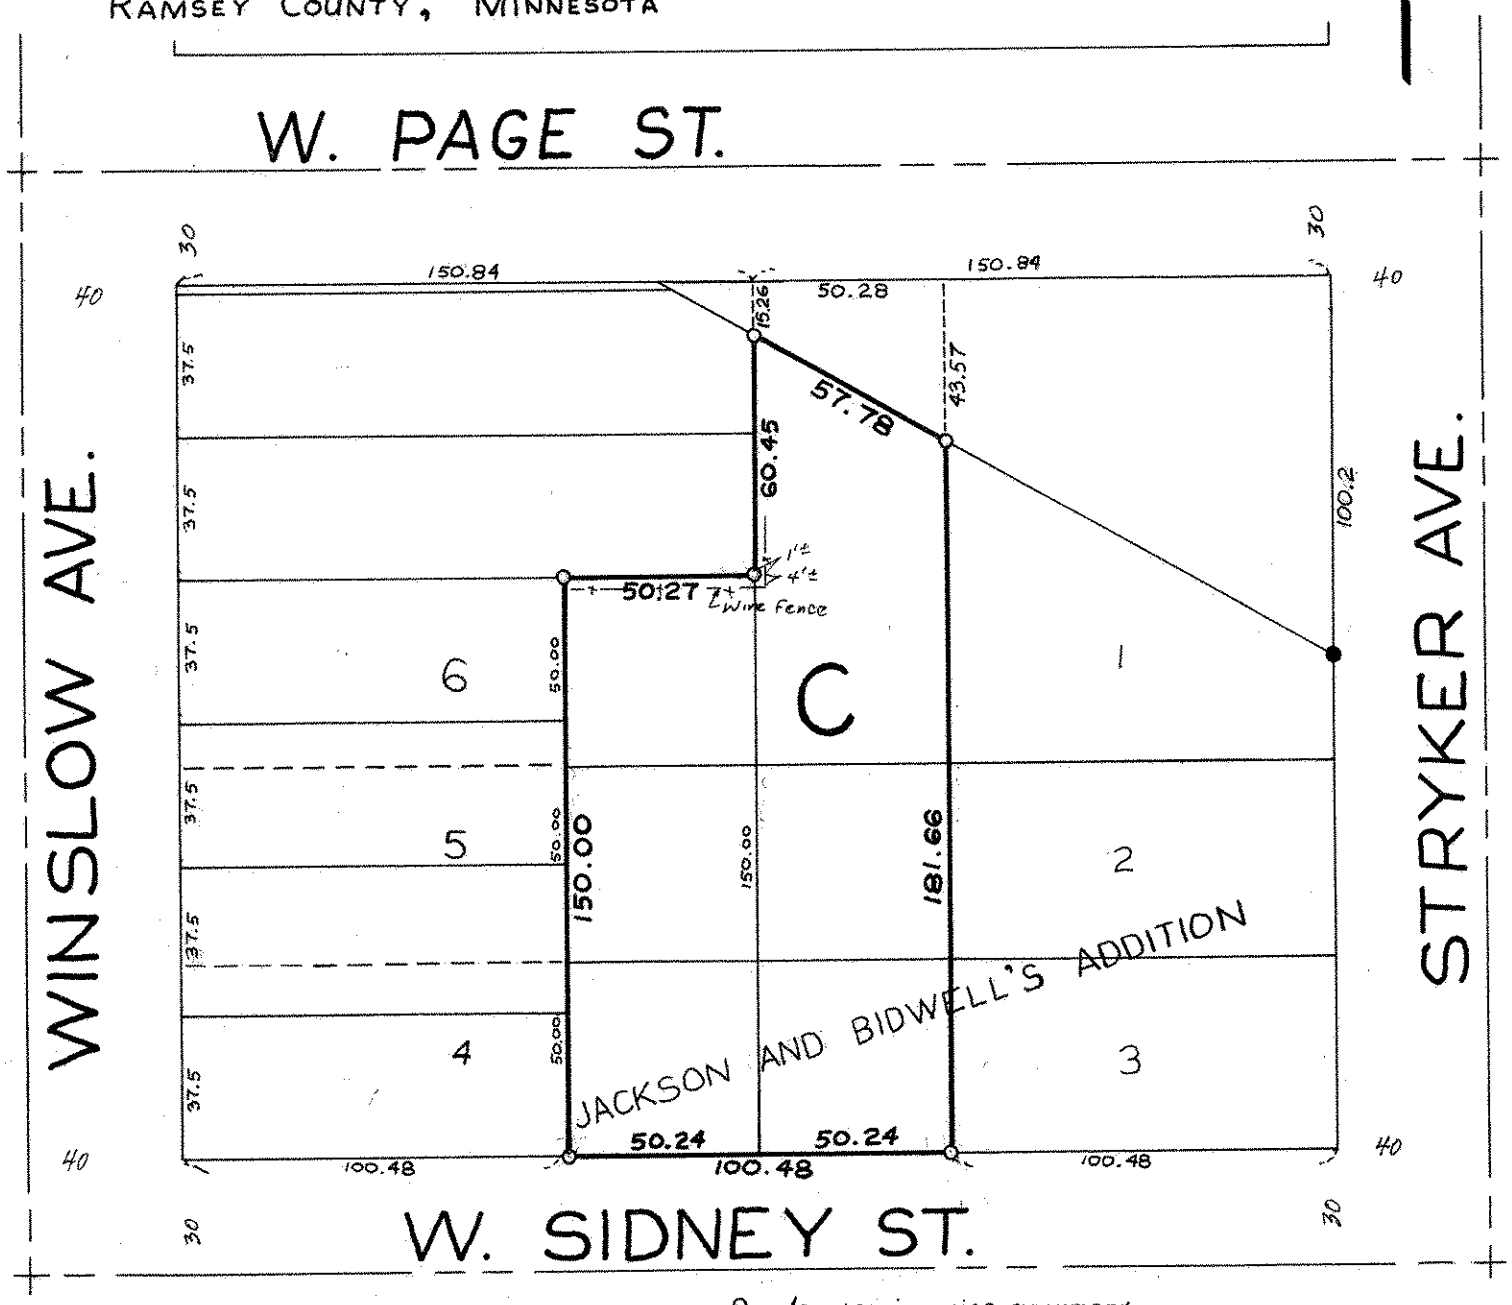

o denotes iron pipe monument
● denotes iron pipe monument found in place