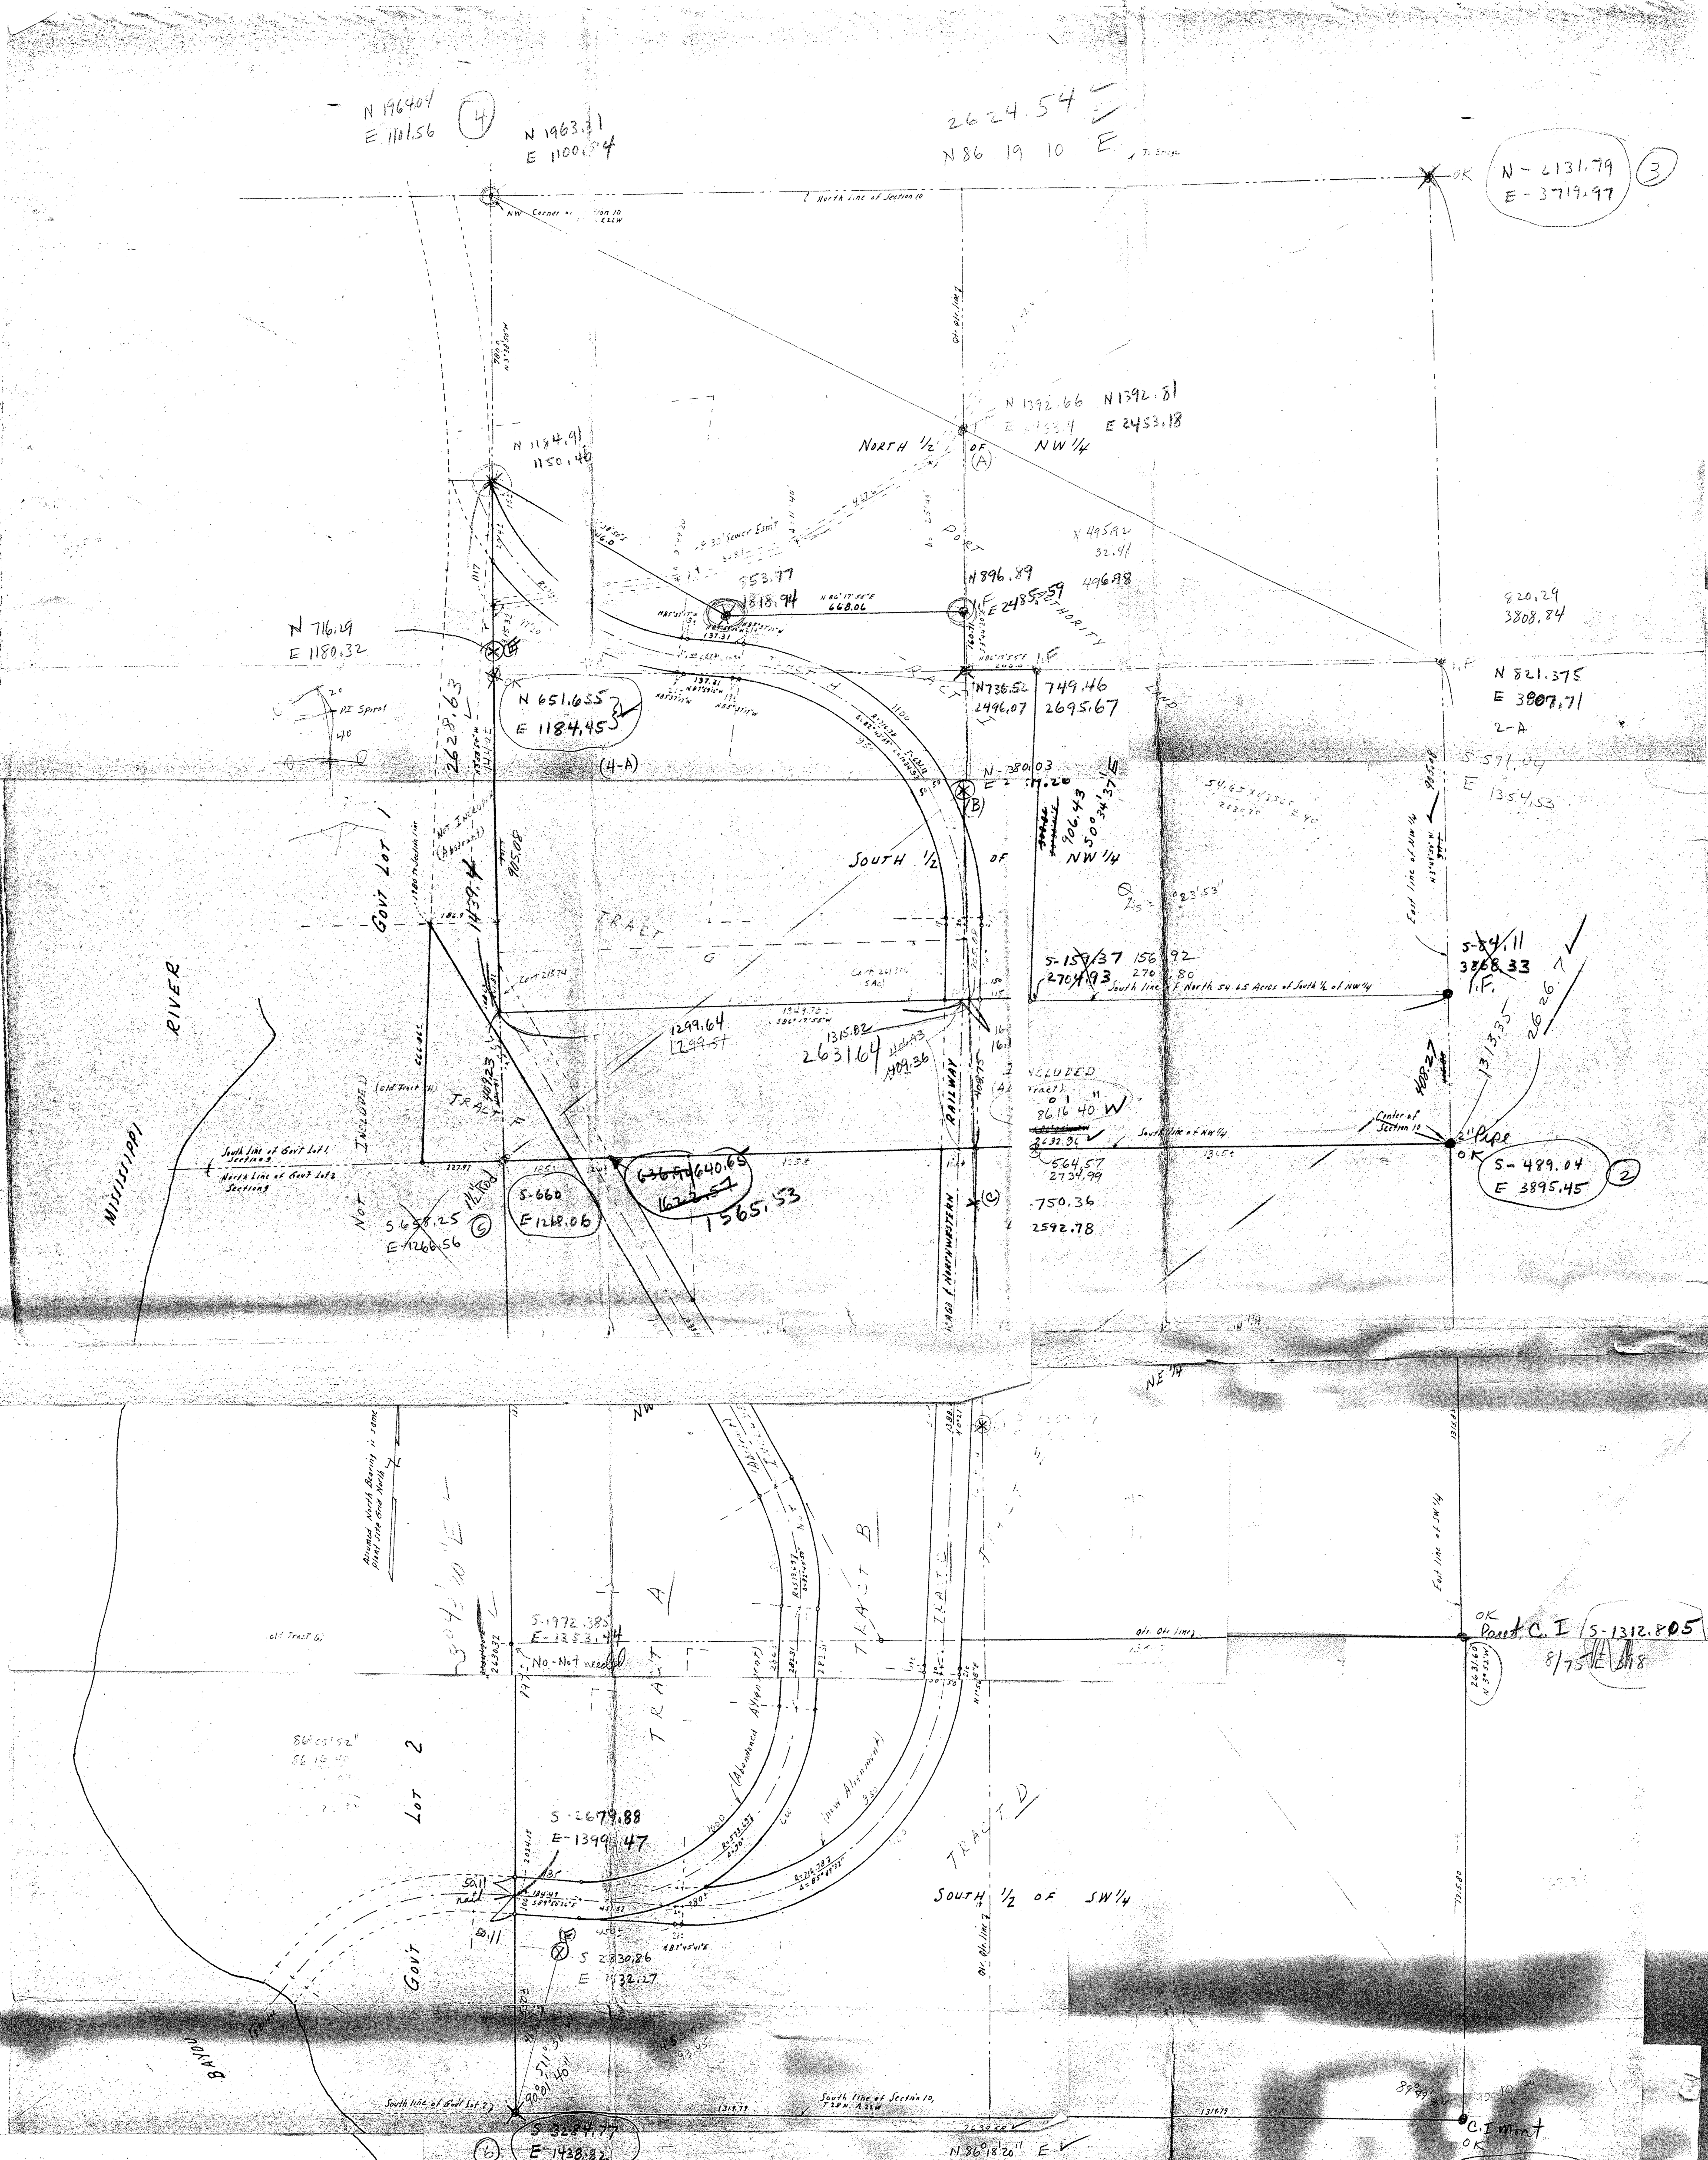

Description:

J. R. Hibbs, Attorney, Dorsey, Marquart, Windhorst, West & Halladay 340-2600 will furnish descriptions, as they appear on title, to be used hereon.

General Note:

The area covered by the survey was generally agreed upon by the Attorney and Registrar of Titles in order to provide clear title to the Railway across Registered Property, & new alignment.

For convenience the entire site is shown hereon, however with Registered Land Surveys for recording being 14"x17", 2 or 3 sheets will be used for the drawing with match lines plus additional sheets for the descriptions.

Proposed REGISTERED LAND SURVEY

PORTION OF METRO WASTEWATER TREATMENT PLANT

ST. PAUL, MINN

SCALE 1" = 200'

Brown - Correct Coord -
Red - Present Coord -
X - [illegible]

CHARLES [illegible] COMPANY
CIVIL ENGINEERING & LAND SURVEYING
3093 N. Lexington Ave
St Paul Minn 55113
[illegible]

April [illegible] 1975
5/20/75 Add sewer esm't in N 1/2 of NW 1/4 & revised Tract F