

Phone 735-4343

Res.: 2141 East 5th Street
St. Paul, Minn. 55119
Off.: 1911 Stillwater Avenue
St. Paul, Minn. 55119


Lake and Land Surveying Co.

WARREN I. FORSBERG, Registered Land Surveyor

SURVEY FOR: ROBERT LA COSSE

described as: THE WEST 50.00 FEET OF THE EAST 100.00 FEET OF LOTS 4, 5 AND 6, BLOCK 5, MURRAY'S 2ND ADDITION

NORTH
AVE.
BLOOM

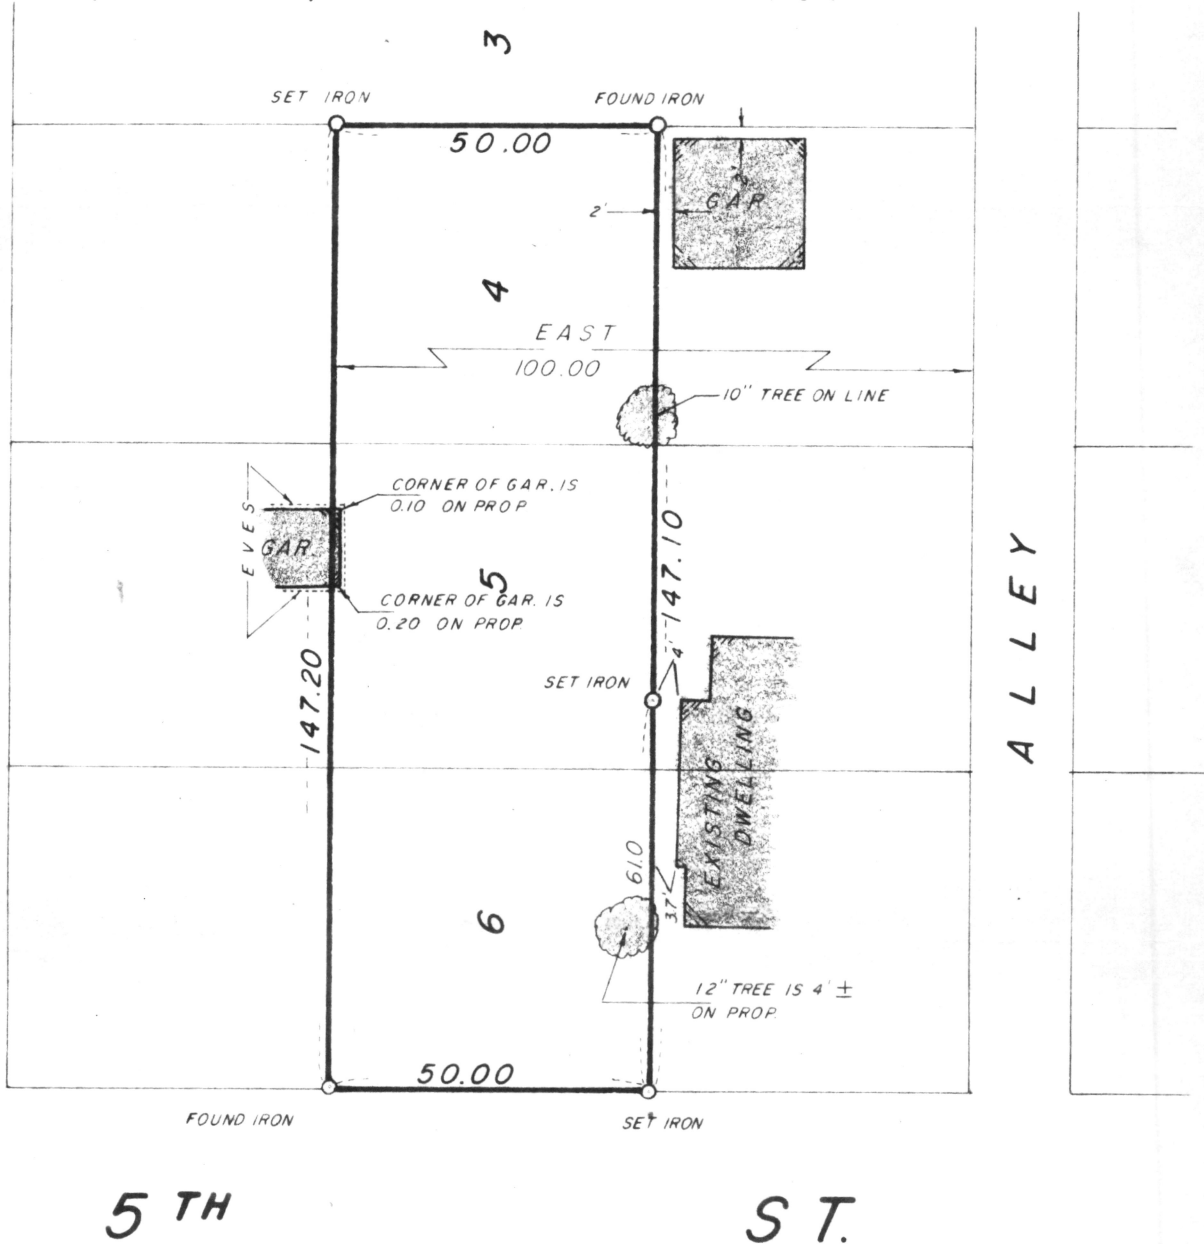

I hereby certify that this survey, plan or report was prepared by me or under my direct supervision and that I am a duly Registered Land Surveyor under the laws of the State of Minnesota.

Signed: *Warren I. Forsberg*

Date: APRIL 15, 1975 Reg. No. 4840 Minnesota
S - 1162 Wisconsin

Scale: 1 inch 30 feet
O—Indicates Iron Monument.