NE 35 30 23

FROM THE OFFICE OF

CHARLES O. GEORGI COMPANY

2215 West County Road B Saint Paul, Minnesota 55113

REGISTERED CIVIL ENGINEER AND LAND SURVEYOR

Certificate of Survey

I Hereby Certify that **this plat shows a survey made by me of the property described on this plat, and that the corners are correctly placed as shown, and that all locations have been correctly shown.**

Surveyed For Wes Robertson

Date May 1976

Scale 1"=100'

By Charles O. Georgi
REGISTERED LAND SURVEYOR

Description:

The North 75.0 feet of South 150.0 feet of Lot 5, Owasso Park except the West 300.0 feet thereof.
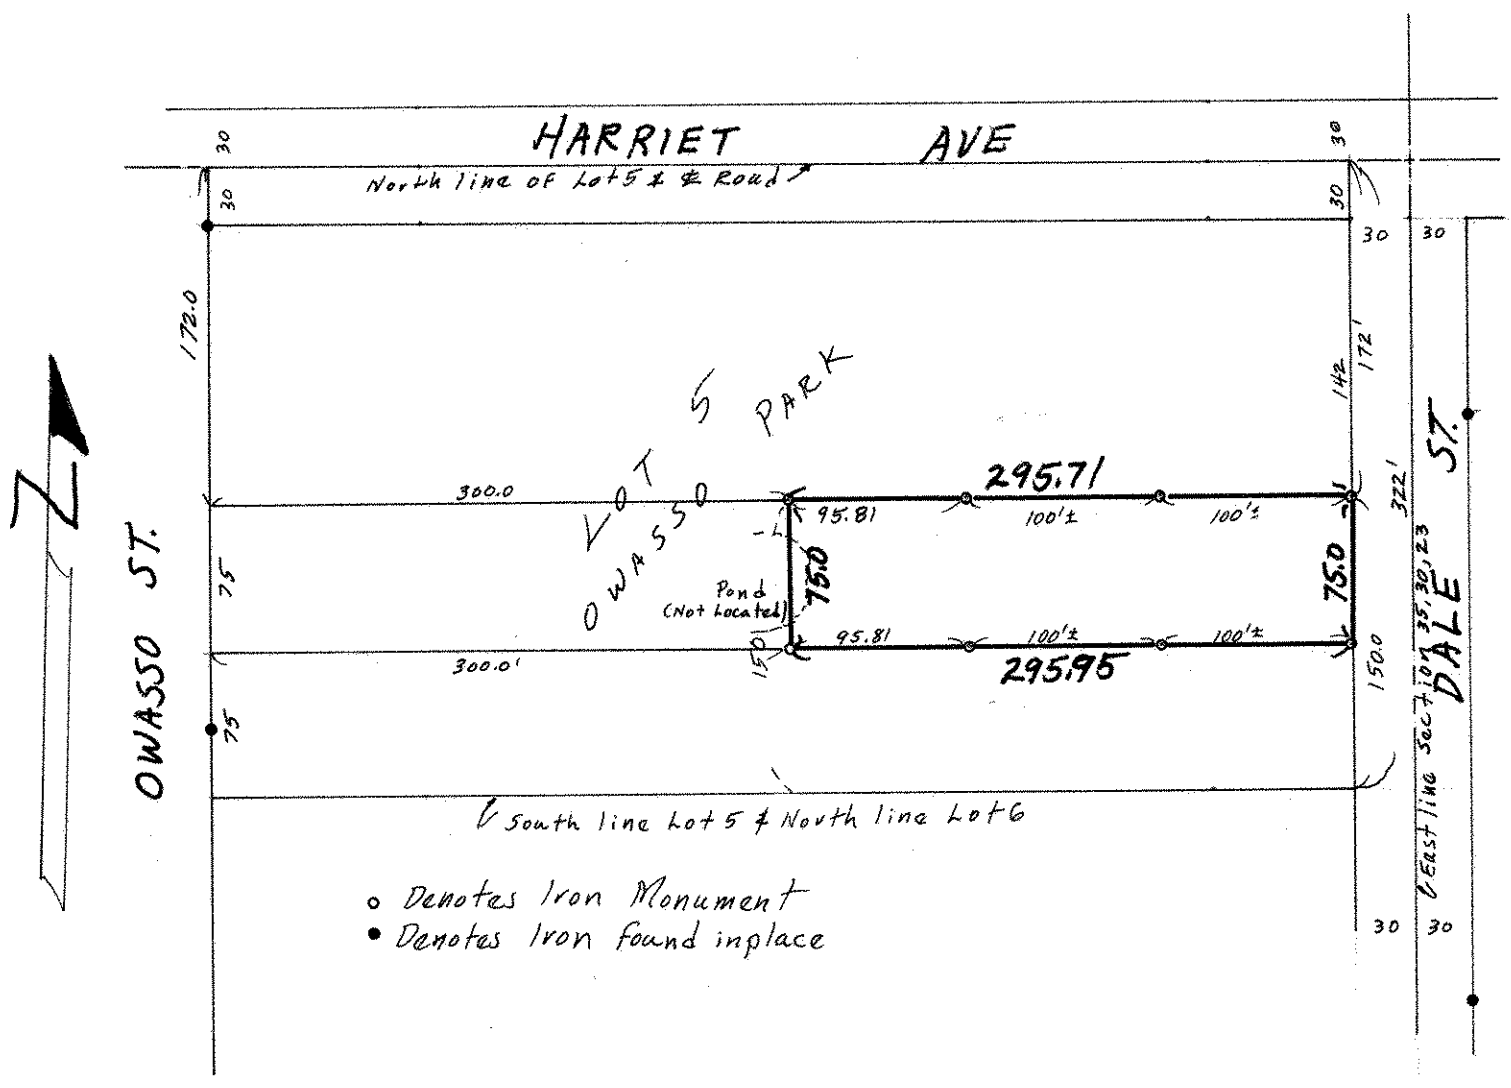
Ramsey County, Minnesota