FROM THE OFFICE OF

## Certificate of Survey

## **CHARLES O. GEORGI COMPANY**

2215 West County Road B

Saint Paul, Minnesota 55113

REGISTERED CIVIL ENGINEER AND LAND SURVEYOR

I Hereby Certify that this plat shows a survey made by me of the property described on this plat, and that the corners are correctly placed as shown, and that all locations have been correctly shown.


Surveyed For Poud Palmer

Date April 1976 1"=40"

Description:

Lot 7, Block 1, Green Acres, Ramsey County,

Minnesota

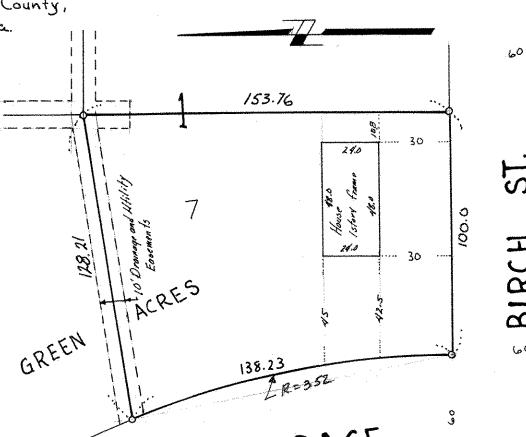

OAK TERRACE