SW 25 30 22

FROM THE OFFICE OF

CHARLES O. GEORGI COMPANY

2215 West County Road B Saint Paul, Minnesota 55113

REGISTERED CIVIL ENGINEER AND LAND SURVEYOR

Certificate of Survey

I Hereby Certify that **this plat shows a survey made by me of the property described on this plat, and that the corners are correctly placed as shown, and that all locations have been correctly shown.**

Surveyed For Robert W. Mick

Date April 1976

Scale 1" = 50'

By Charles O. Georgi

REGISTERED LAND SURVEYOR

Description:

Lot 20, Block 19

Bacchus Fourth Addition,
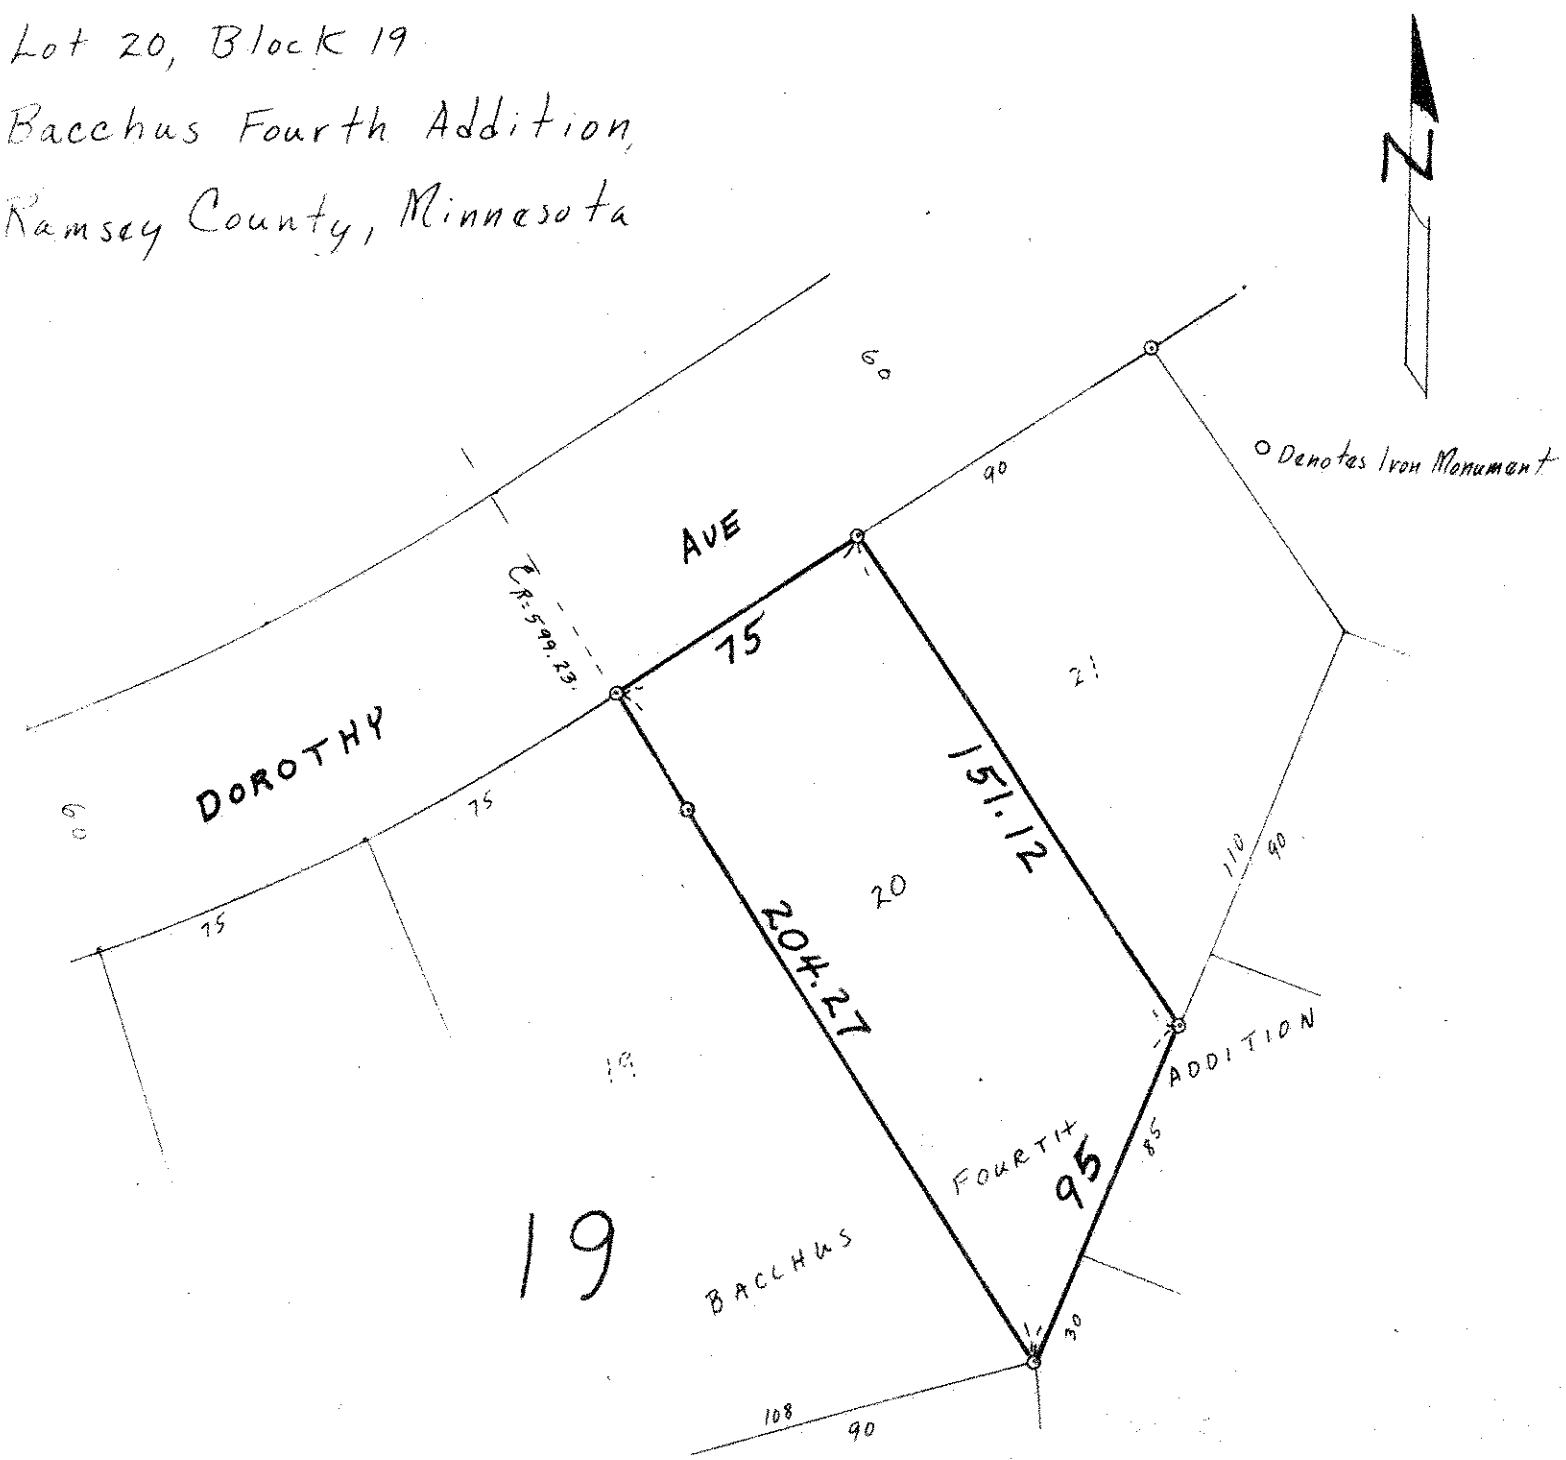
Ramsey County, Minnesota