

FROM THE OFFICE OF

**CHARLES O. GEORGI COMPANY**

2215 West County Road B

Saint Paul, Minnesota 55113

REGISTERED CIVIL ENGINEER AND LAND SURVEYOR

**Certificate  
of Survey**

*I Hereby Certify that this plat shows a survey made by me of the property described on this plat, and that the corners are correctly placed as shown, and that all locations have been correctly shown.*

Surveyed For Orville L. Eriksen - Sunrise Builders


Date July 1976

Scale 1" = 40'

By Charles O. Georgi  
REGISTERED LAND SURVEYOR

**Description:**

Lots 8 and 9, Block 1,  
Sunrise Park,  
Ramsey County, Minnesota

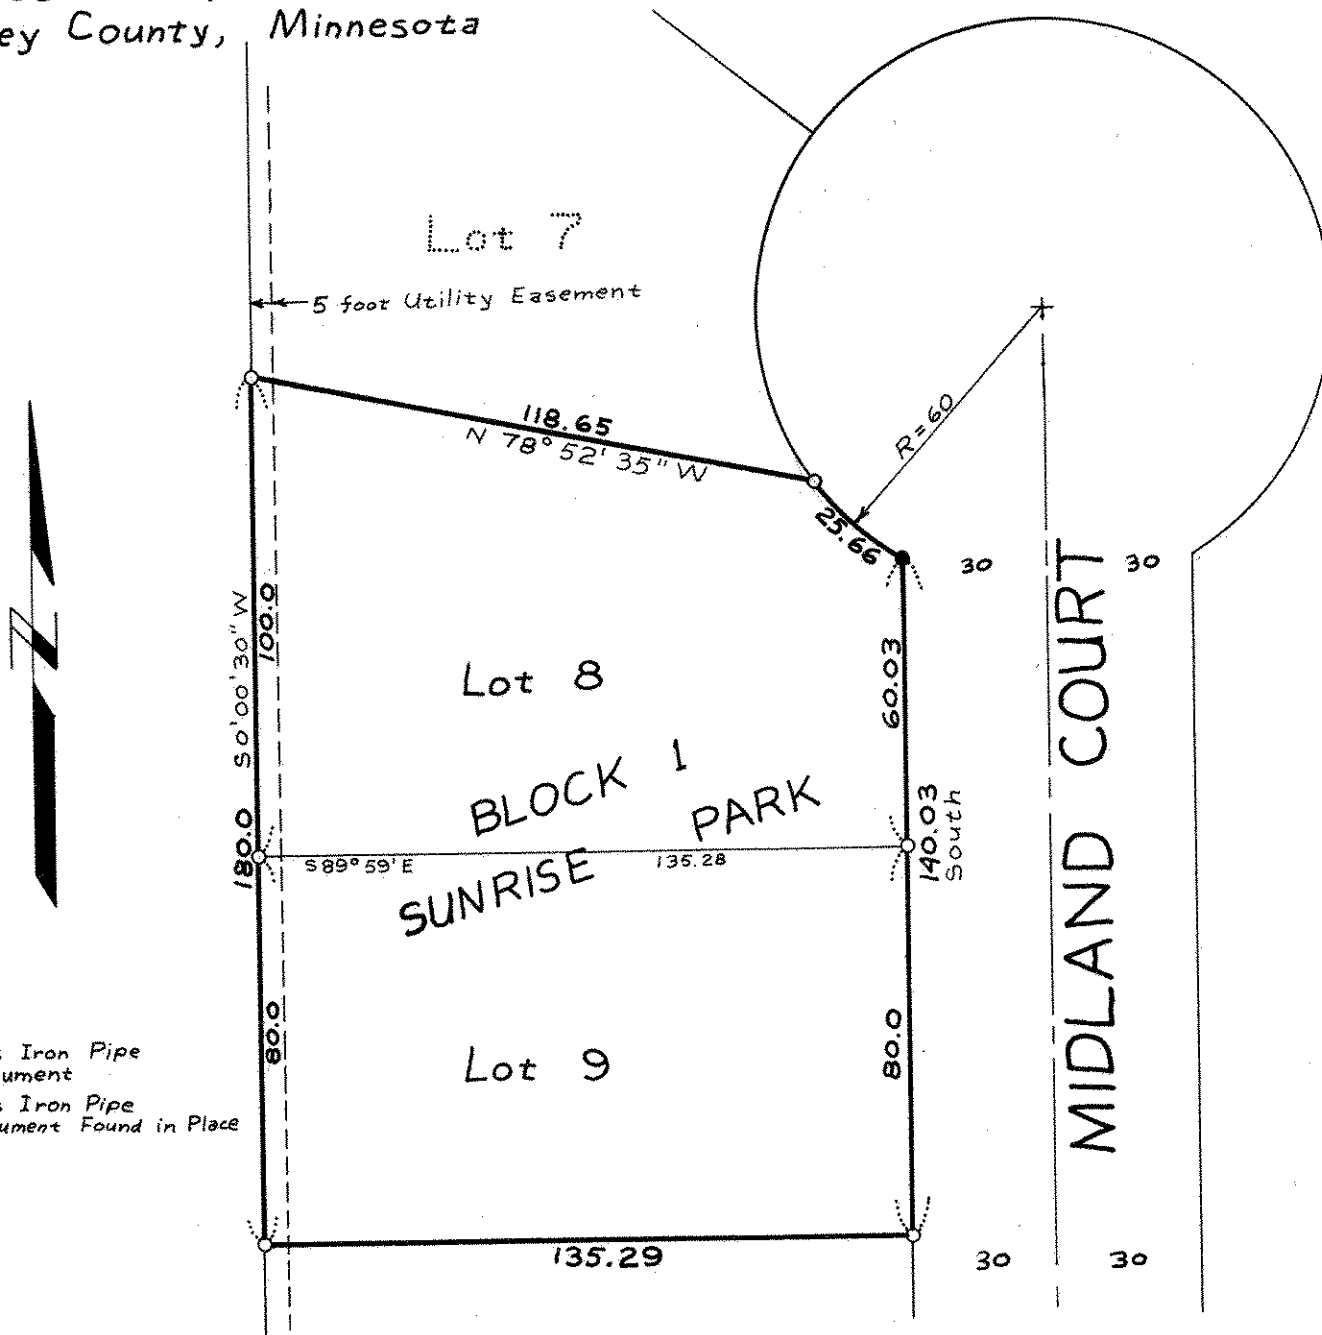

○ Denotes Iron Pipe Monument  
● Denotes Iron Pipe Monument Found in Place