SE 36 30 32

FROM THE OFFICE OF

CHARLES O. GEORGI COMPANY

2215 West County Road B Saint Paul, Minnesota 55113

REGISTERED CIVIL ENGINEER AND LAND SURVEYOR

Certificate of Survey

I Hereby Certify that **this plat shows a survey made by me of the property described on this plat, and that the corners are correctly placed as shown, and that all locations have been correctly shown.**

Surveyed For Bruggeman Const.

Date August 1976

Scale 1" = 40'

By Charles O. Georgi
REGISTERED LAND SURVEYOR

Description:

Lots 3,4,5 and 6,
Block 1,
Lakewood Village No. 2,
Ramsey County, Minnesota

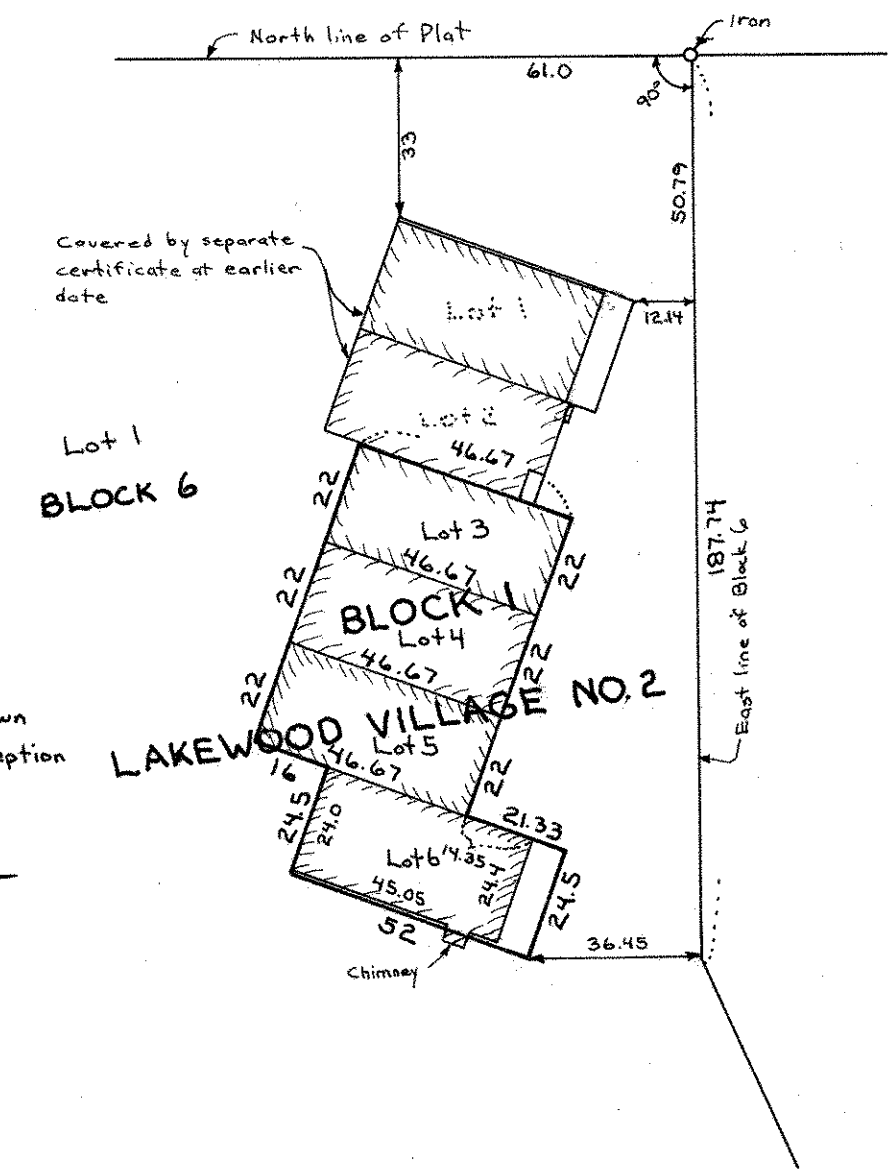

Surveyor's Note:
All of the townhouses on Lots 3-6 Block 1, Lakewood Village No. 2, as shown are within the boundary line with exception of the chimney and the party walls.

Townhouses still under construction — nearly complete

Width may vary by 0.1' ±.