

Certificate of Survey

From the office of
GEORGI-SCHMIDT & ASSOC. INC.
 3092 No. Lexington Ave., Roseville, Mn. 55113
 LAND SURVEYING
 483-4408

I Hereby Certify that this plat shows a survey made by me of the property described on this plat, and that the corners are correctly placed as shown, and that all locations have been correctly shown.

Job Number: 10

Surveyed For Doris Mikeworth


Date July 17, 1976

Scale 1"=40'

By Donald W. Schmidt
 REGISTERED LAND SURVEYOR

Description:

Lot 5,
 Block 4,
 Mikeworth Addition,
 Ramsey County, Minnesota.

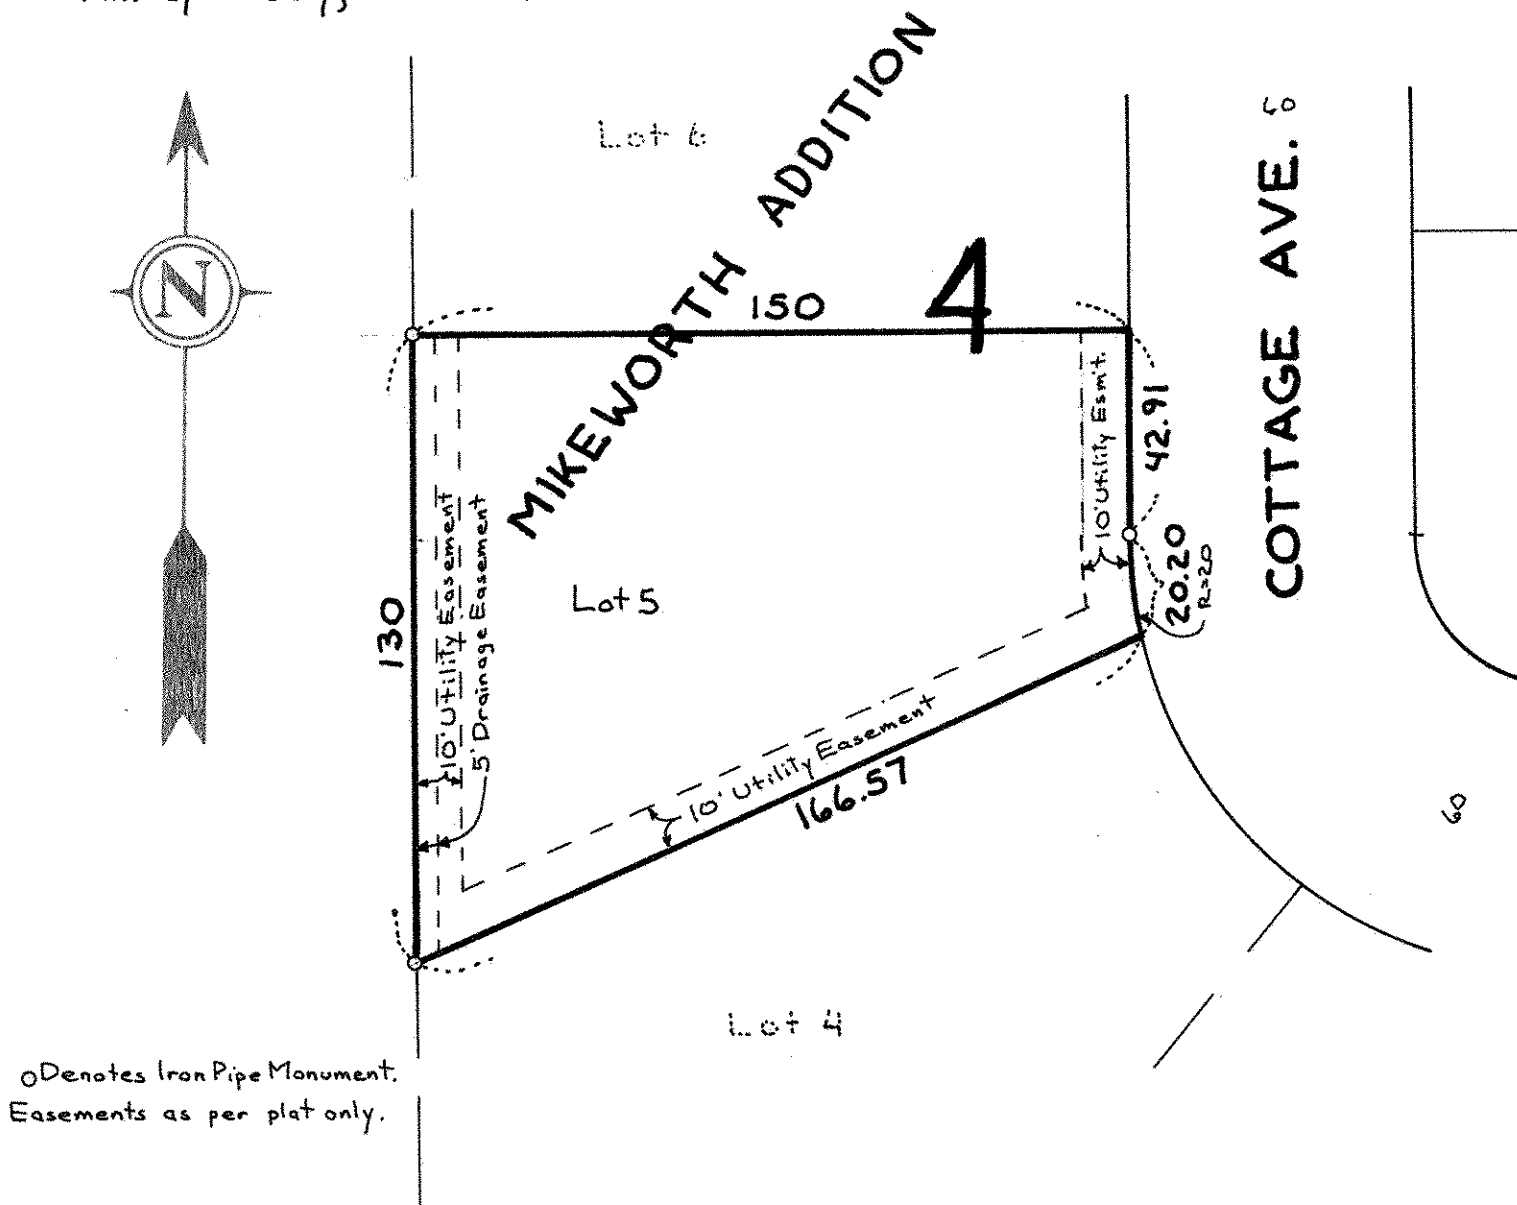

○ Denotes Iron Pipe Monument.
 Easements as per plat only.