FROM THE OFFICE OF

Certificate of Survey


CHARLES O. GEORGI COMPANY

RECEITERED CIVE, ENGINEER AND LAND SURVEYOR

I Hereby Certify that this plat shows a survey made by me of the property described on this plat, and that the corners are correctly placed as shown, and that all locations have been correctly shown.

Surveyed For Hugh B. Heckal Date October 1976 1":60" Scale.

Description:

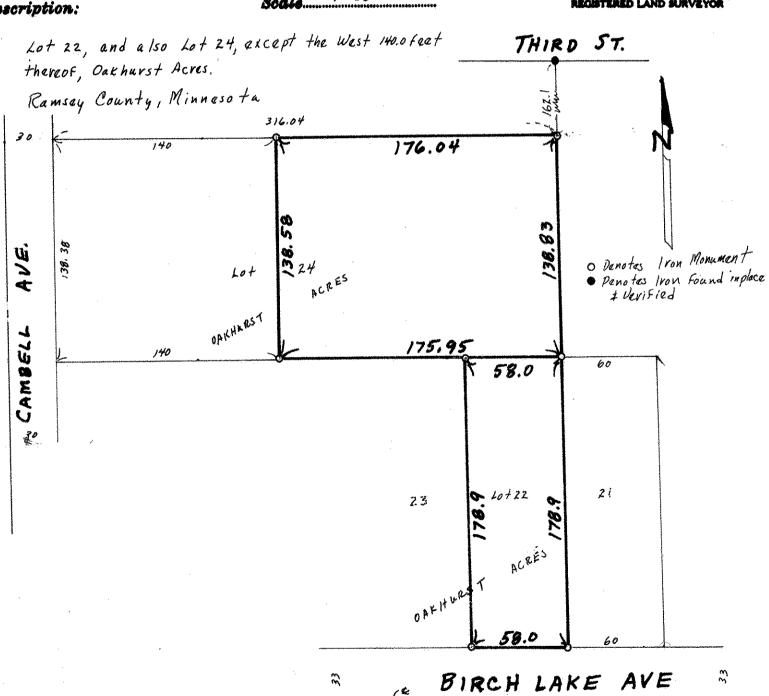

BIRCH LAKE AVE Eso Line of Saction 14, T30NR22N