FROM THE OFFICE OF

CHARLES O. GEORGI COMPANY

2215 West County Road B

Saint Paul, Minnesota 55113

REGISTERED CIVIL ENGINEER AND LAND SURVEYOR


I Hereby Certify that this plat shows a survey made by me of the property described on this plat, and that the corners are correctly placed as shown, and that all locations have been correctly shown.

Surveyed For Roger Shiple	}
Date May 1976	By Sha
Scale	REGI

Description:

Lot 10, Block 2, Goodrich Homesites, Ramsey County, Minnesota

Certificate of Survey

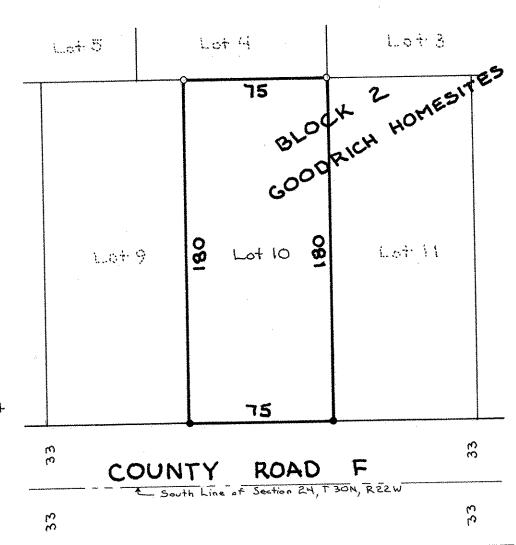



- O Denotes Iron Pipe Monument
- Denotes Iron Pipe Monument found in place.