NE 20 29 22

FROM THE OFFICE OF

CHARLES O. GEORGI COMPANY

2215 West County Road B Saint Paul, Minnesota 55113

REGISTERED CIVIL ENGINEER AND LAND SURVEYOR

Certificate of Survey

I Hereby Certify that **this plat shows a survey made by me of the property described on this plat, and that the corners are correctly placed as shown, and that all locations have been correctly shown.** 5/24/76 Revised Easterly parcel to 20' and added description

Surveyed For Raymond Resch

Date May 1976

Scale 1" = 50'

By Charles O. Georgi
REGISTERED LAND SURVEYOR

Description:
Total parcel:
The South 1/2 of Lots 13, 14, and 15, Block 13, Harrison and Hardy's Addition to the City of St. Paul.
Ramsay County, Minn.
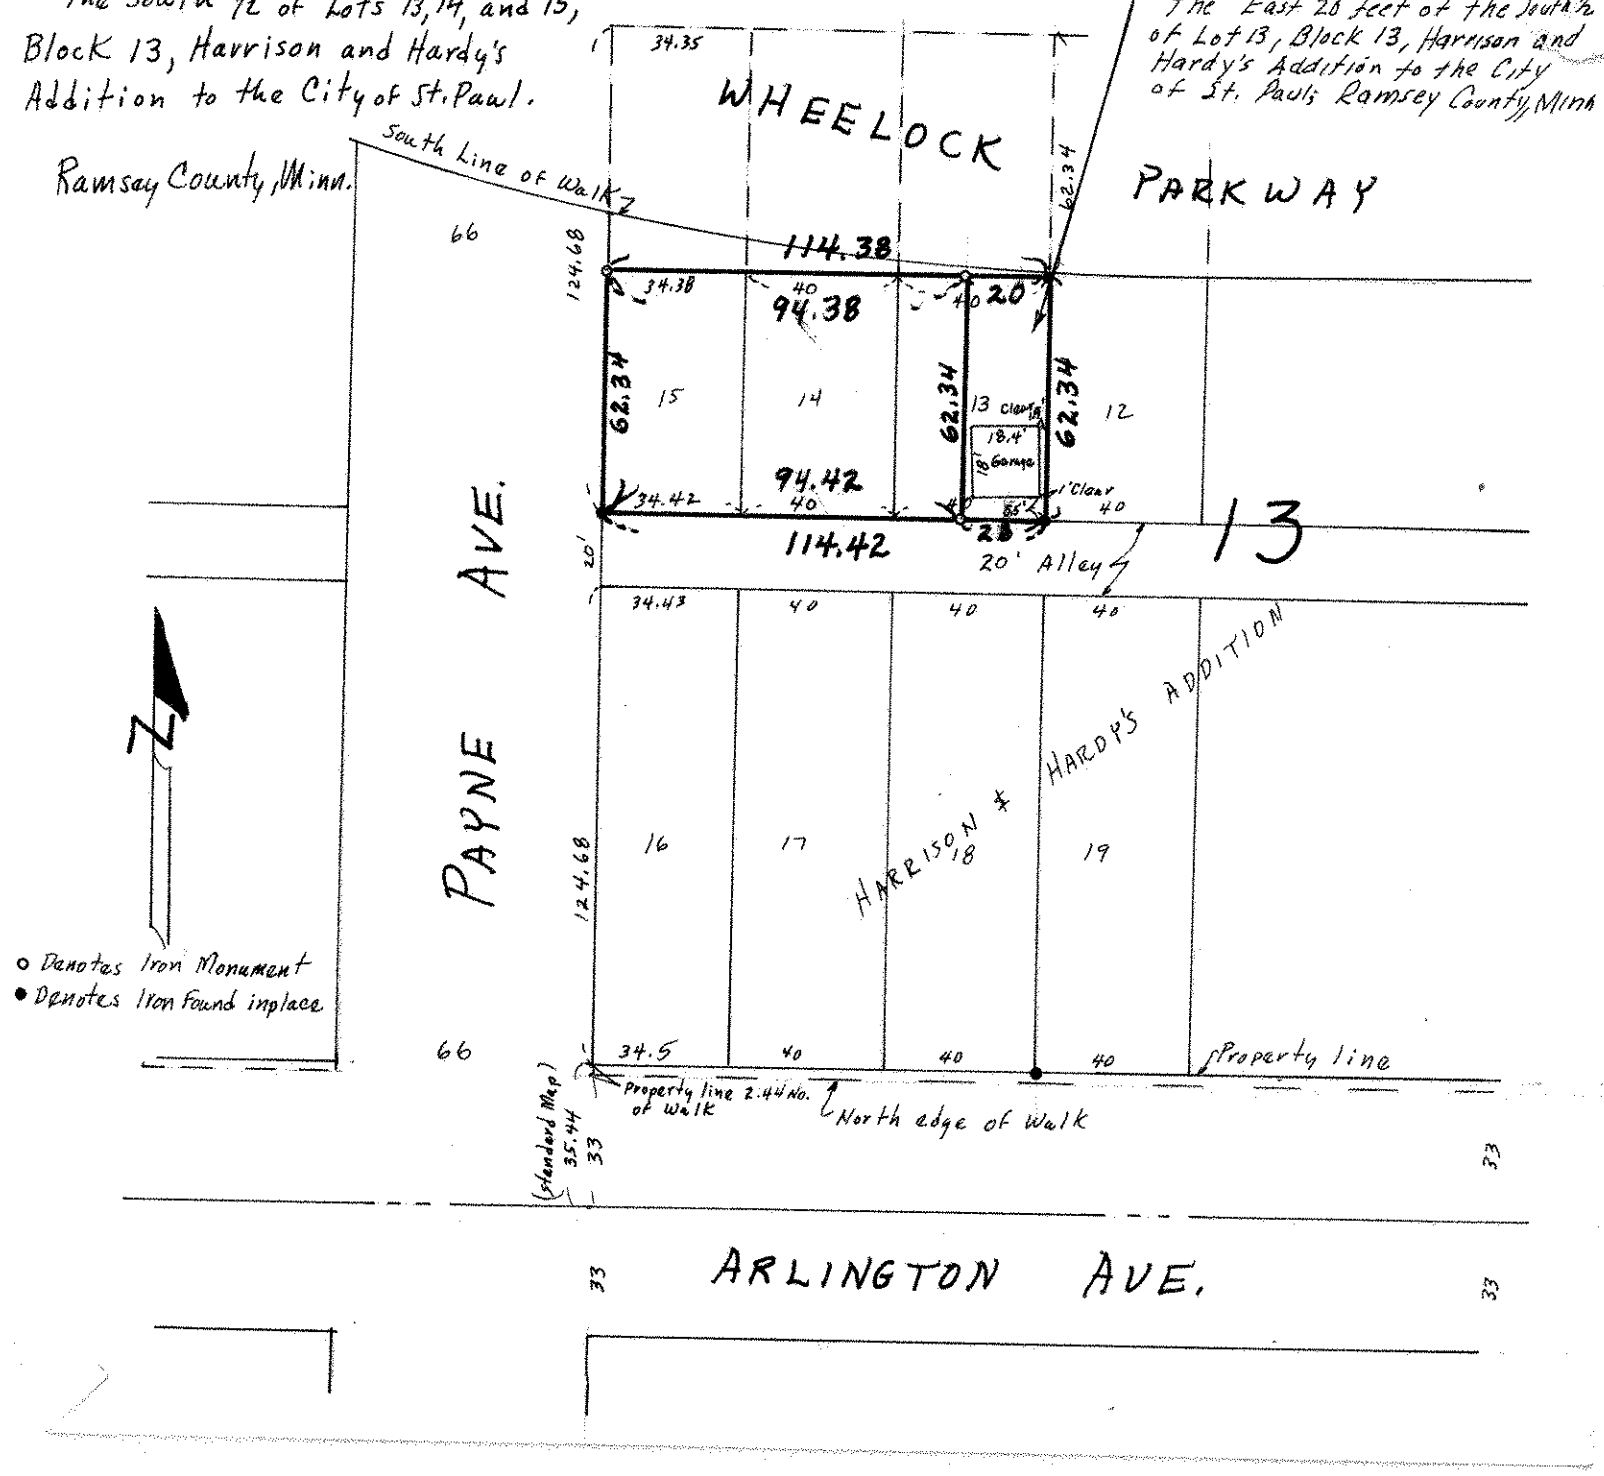
Description
The East 20 feet of the South 1/2 of Lot 13, Block 13, Harrison and Hardy's Addition to the City of St. Paul; Ramsey County, Minn