SE 15 30 22

FROM THE OFFICE OF

CHARLES O. GEORGI COMPANY

2215 West County Road B Saint Paul, Minnesota 55113

REGISTERED CIVIL ENGINEER AND LAND SURVEYOR

Certificate of Survey

I Hereby Certify that **this plat shows a survey made by me of the property described on this plat, and that the corners are correctly placed as shown, and that all locations have been correctly shown.**

Surveyed For James Kohler

Date September 1976

Scale 1" = 40'

By Charles O. Georgi

REGISTERED LAND SURVEYOR

Description:
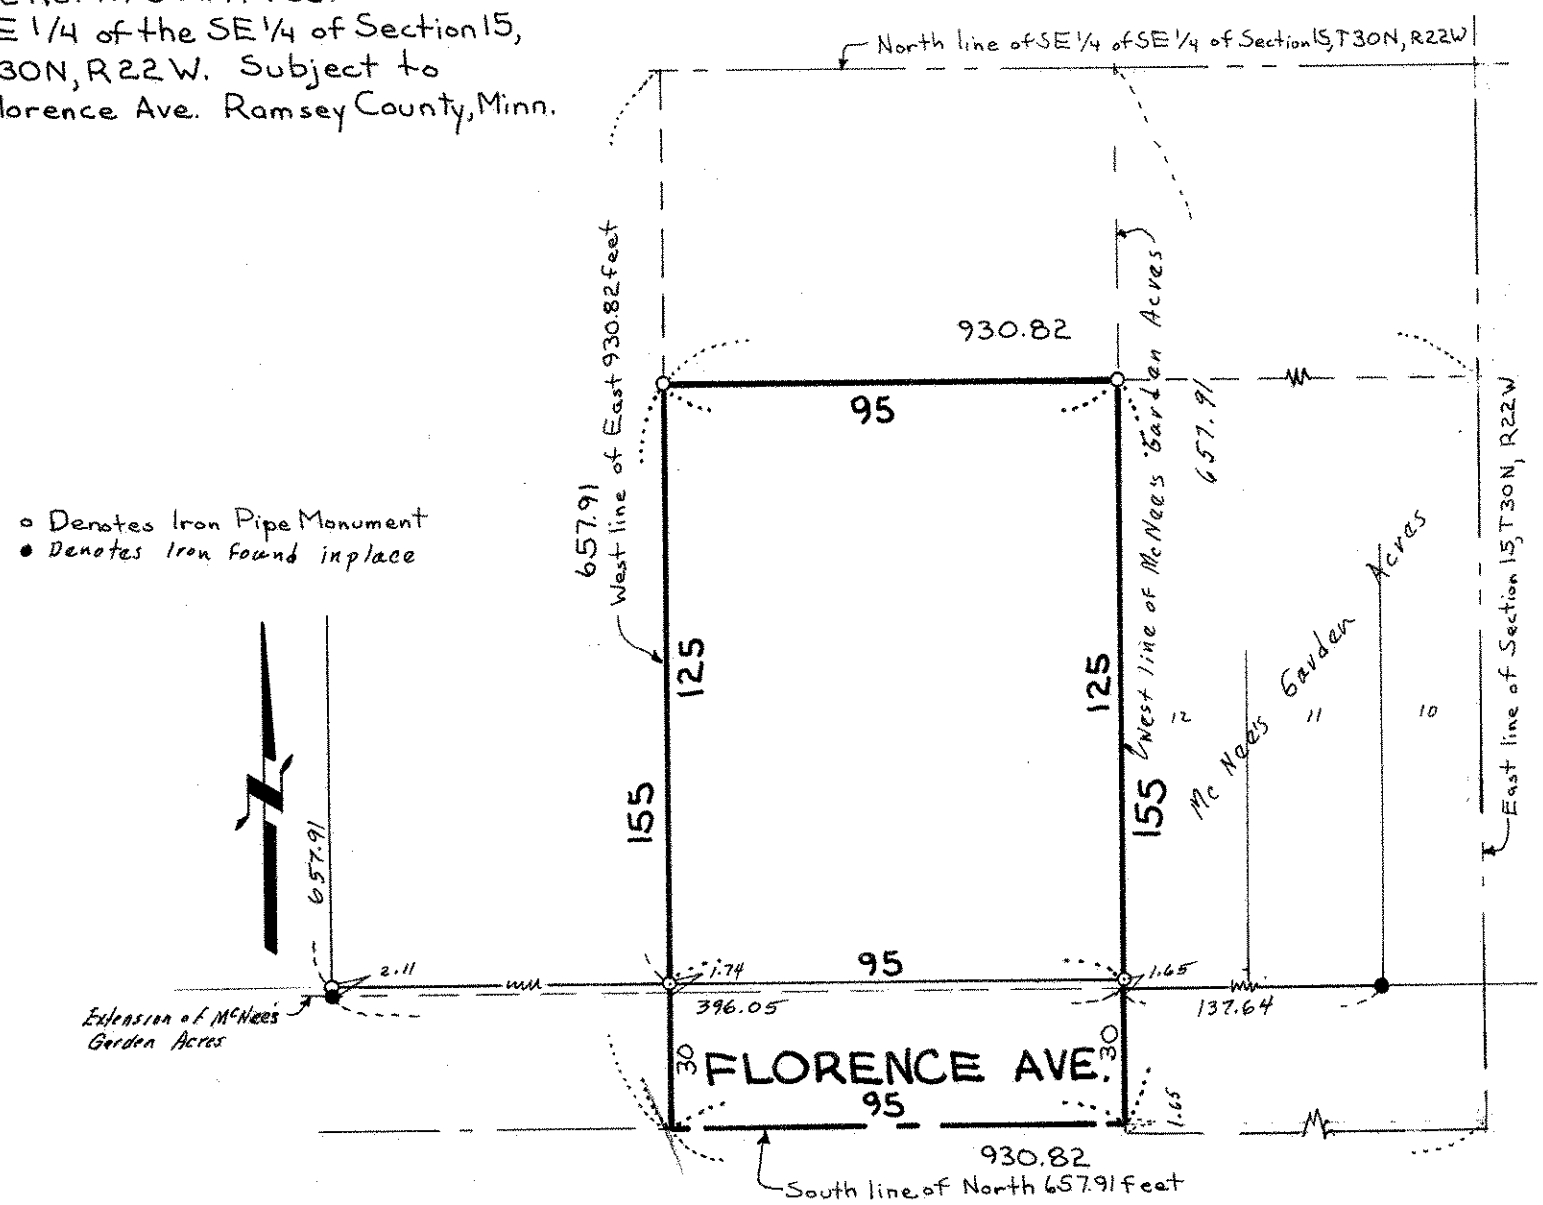
The West 95 feet of the East 930.82 of the South 155 feet of the North 657.91 feet of the SE 1/4 of the SE 1/4 of Section 15, T 30N, R 22 W. Subject to Florence Ave. Ramsey County, Minn.